

MISSISSIPPI DEPARTMENT OF ENVIRONMENTAL QUALITY
Bureau of Land and Water Resources

P. O. Box 10631
Jackson, MS 39289-0631
WATER WELL DRILLERS LOG

COUNTY WELL LOCATED <u>Washington</u>	
WELL NUMBER <u>122</u>	CODED <input checked="" type="checkbox"/>
DATE WELL COMPLETED <u>7-23-91</u>	

166A

PERMIT NUMBER
NAME OF DRILLING FIRM <u>Schultz Drilling</u>

NAME & MAILING ADDRESS OF LANDOWNER <u>Farm Fresh</u>		
<u>P.O. Box 348</u>		
<u>Lake Village Ark.</u>		
WELL LOCATION: SEC	TOWNSHIP	RANGE
<u>19</u>	<u>16</u>	<u>7</u>
DISTANCE		DIRECTION
<u>6</u> Miles		<u>NW</u> of <u>Hollandale</u>
OTHER LANDMARK		
WELL PURPOSE: Home, Irrigation, Municipal, Industrial, Fish Pond , etc.		


PUMP DATA		
PUMP TYPE (Circle One): Submersible Turbine, Jet, Flowing Well, Other (Describe) _____		
POWER TYPE (Circle One): Electric Tractor, Diesel, Gasoline, Butane, Other (Describe) <u>owner</u> H/P <u>20</u>		
Pump Capacity (GPM)	No. of Stages	Setting Depth
<u>1000</u>	<u>1</u>	<u>60</u> FT.
PUMP TEST		
Well yielded _____ GPM with a drawdown of _____ ft. after _____ hours of pumping		

WELL DATA		
Well Depth <u>77</u>	Casing Diameter (In.) <u>10</u>	Casing Length (Ft.) <u>57</u>
Type of Casing <u>pvc</u>	Hole Depth <u>77</u>	Depth to Static Water Level <u>27</u>
TYPE OF COMPLETION: (Circle One or More): Gravel Packed Underreamed, Telescoped, Natural Development, Open Hole, Other (Describe) <u>Hole plug</u>		
Top of Lap Pipe or Reduction in Casing		
FEET	IF TELESCOPED OR MORE THAN ONE SCREEN: USE BACK PAGE	

LOG DATA	
TYPE OF LOG RUN (Circle One): Electric, Gamma Ray, Density, Sonic, Neutron, Other (Describe) _____	
Name of Organization Running Log	


SCREEN DATA		
Diameter - Inches <u>10</u>	Length - Feet <u>20</u>	Slot Size - Inches <u>1032</u>
Screen Type <u>pvc</u>	Depth to Bottom - Feet <u>77</u>	

GEOLOGIC DATA (Office Use Only)			
Surface Elev.	Geologic Unit	Unit Thickness	Depth to Top
Subs. SWL	Date	Analysis	Aquifer Test
Driller's Remarks			

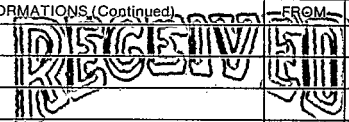DESCRIPTION OF FORMATIONS ENCOUNTERED	FROM	TO	FORMATIONS (Continued)	
			FROM	TO
<u>clay</u>	<u>0</u>	<u>35</u>		<u>10</u>
<u>sand</u>	<u>35</u>	<u>45</u>		
<u>med sand - little p-g</u>	<u>45</u>	<u>77</u>		
			DEC 06 1991	
			Dept. of Environmental Quality Bureau of Land & Water Resources	
			IF MORE SPACE IS NEEDED, USE BACK	

If well telescopes please sketch and show depths.

GROUND LEVEL

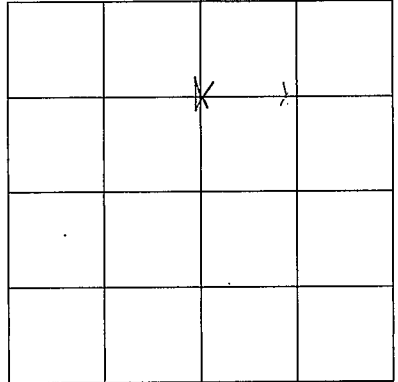

SECTION 19

Please indicate well location X.

ADDITIONAL INFORMATION

(Faint, illegible markings)

If more than one screen, show location of each on sketch.