

MISSISSIPPI DEPARTMENT OF ENVIRONMENTAL QUALITY

Office of Land and Water Resources

P. O. Box 10631
Jackson, MS 39289-0631
WATER WELL DRILLERS LOG

COUNTY WELL LOCATED <i>Washington</i>	
WELL NUMBER <i>L130</i>	CODED <input checked="" type="checkbox"/>
DATE WELL COMPLETED <i>8-4-98</i>	

PERMIT NUMBER
NAME OF DRILLING FIRM <i>Schudco Ltd</i>

NAME & MAILING ADDRESS OF LANDOWNER <i>Malcom Whitt</i>			
<i>Douglas Rd</i>			
<i>Greenwill MS 38701</i>			
WELL LOCATION:	SEC	TOWNSHIP	RANGE
	<i>19</i>	<i>16 S</i>	<i>7 E</i>
DISTANCE	DIRECTION	NEAREST TOWN	
<i>5</i> Miles	<i>SE</i>	<i>Wayside</i>	
OTHER LANDMARK			
WELL PURPOSE: <u>Home</u> , Irrigation, Municipal, Industrial, Fish Pond, etc.			

PUMP DATA		
PUMP TYPE (Circle One): <u>Submersible</u> , Turbine, Jet, Flowing Well, Other (Describe)		
POWER TYPE (Circle One): <u>Electric</u> , Tractor, Diesel, Gasoline, Butane, Other (Describe) H/P <i>1 1/2</i>		
Pump Capacity (GPM) <i>27</i>	No. of Stages	Setting Depth <i>105</i> FT.
PUMP TEST		
Well yielded _____ GPM with a drawdown of _____ ft. after _____ hours of pumping		

WELL DATA		
Well Depth <i>440</i>	Casing Diameter (In.) <i>4x2</i>	Casing Length (Ft.) <i>410</i>
Type of Casing <i>pvc</i>	Hole Depth <i>440</i>	Depth to Static Water Level
TYPE OF COMPLETION: (Circle One or More): <u>Gravel Packed</u> , Underreamed, Telescoped, <u>Natural Development</u> , Open Hole, Other (Describe)		

LOG DATA	
TYPE OF LOG RUN (Circle One): <u>No Log Run</u> , Electric, Gamma Ray, Density, Sonic, Neutron, Other (Describe)	
Name of Organization Running Log	

WELL GROUTED TO A DEPTH OF <u>10</u> FEET Type Grout (circle one): <u>Cement</u> Bentonite, or Mix

GEOLOGIC DATA (Office Use Only)			
Surface Elev.	Geologic Unit	Unit Thickness	Depth to Top
Subs. SWL	Date	Analysis	Aquifer Test

SCREEN DATA		
Diameter - Inches <i>2</i>	Length - Feet <i>30</i>	Slot Size - Inches <i>.008</i>
Screen Type <i>pvc</i>	Depth to Bottom - Feet <i>440</i>	


Driller's Remarks
Top of Lap Pipe or Reduction in Casing
FEET <input type="checkbox"/> IF TELESCOPED OR MORE THAN ONE SCREEN: USE BACK PAGE

DESCRIPTION OF FORMATIONS ENCOUNTERED	FROM	TO	FORMATIONS (Continued)	FROM	TO
<i>Gumbo</i>	<i>0</i>	<i>26</i>			
<i>sand</i>	<i>26</i>	<i>78</i>			
<i>clay + shell</i>	<i>78</i>	<i>360</i>			
<i>sand</i>	<i>360</i>	<i>440</i>			

IF MORE SPACE IS NEEDED, USE BACK

If well telescopes please sketch and show depths.

GROUND LEVEL

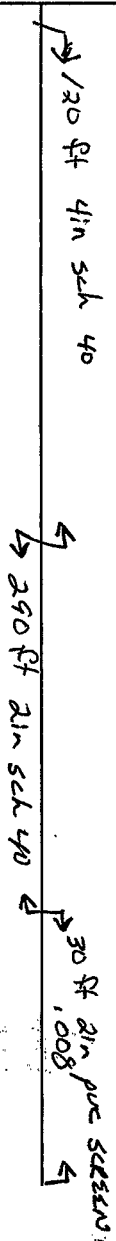

X			

SECTION 19

Please indicate well location X.

ADDITIONAL INFORMATION

Lined area for additional information.

If more than one screen, show location of each on sketch.