

MISSISSIPPI DEPARTMENT OF NATURAL RESOURCES

Bureau of Land and Water Resources

Southport Mall

P.O. Box 10631

Jackson, Mississippi 39209

WATER WELL DRILLERS LOG

CODED

Washington  
L134  
4/13/82

4-13 1982 Schultz Drilling WASH.  
date well completed firm name county well located

LANDOWNER:	description of formations encountered	from	to
LEON Lumley Wilmont Rd, Greenville (mailing address) MS			
WELL LOCATION: sec. 11 T-16 N S R-7 E W 2 miles SW of Arcolia (distance) (direction) (nearest town)			
WELL PURPOSE: IRRIGATION (home, irrigation, municipal, industrial)			
WELL COMPLETION DATA:			
(1) diameter (inches) 12"			
(2) total depth (feet) 100'			
(3) static water level (feet) 22' below top of ground.			
(4) casing PVC 60' (material) (depth)			
(size) If telescope see back.			
(5) screen 40' 60' (length) (depth to top)			
12" PVC slotted (size) (material)			
(6) pump 30 1100 (HP) (yield gpm)			
elb. (type power)			
(7) electric log NO (yes or no)			
(organization running log)			
(8) how well bottom plugged cap/pvc			
DRILLERS REMARKS:			

CODED


DEPT. OF NATURAL RESOURCES  
BUREAU OF LAND & WATER RESOURCES

MAY 21 1982

RECEIVED

If well telescopes please sketch and show depths.

GROUND LEVEL

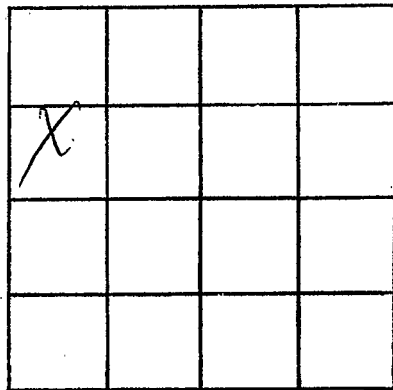

SECTION \_\_\_\_\_

Please indicate well location X.

ADDITIONAL INFORMATION

If more than one screen,  
show locations of each on sketch.