

MISSISSIPPI DEPARTMENT OF ENVIRONMENTAL QUALITY

Office of Land and Water Resources

P. O. Box 10631

Jackson, MS 39289-0631

WATER WELL DRILLERS LOG

COUNTY WELL LOCATED	Washington
WELL NUMBER	L-149
CODED	
DATE WELL COMPLETED	5-12-03

PERMIT NUMBER	GW40373
NAME OF DRILLING FIRM	Chicot Irrigation

NAME & MAILING ADDRESS OF LANDOWNER	COCO PLANTING CO. PO BOX 143 AVON, MS 38723	
Latitude:	33 12 LT 10	
Longitude:	090 57 62 37	
WELL LOCATION	SEC 30 TOWNSHIP 16 N RANGE 7 E	
DISTANCE	DIRECTION	NEAREST TOWN
5 Miles	East	of AVON
OTHER LANDMARK	Water Shed Ditch	
WELL PURPOSE:	Home Irrigation	Municipal, Industrial, Fish Pond, etc.

PUMP DATA		
PUMP TYPE (Circle One):	Submersible, Turbine	Jet Flowing Well.
POWER TYPE (Circle One):	Electric, Tractor, Diesel	Gasoline, Butane, Other (Describe) H/P 600
DESCRIPTION OF FORMATIONS ENCOUNTERED	FROM	TO
Top Soil	0	10
Blue Clay	10	40
Fine sand	40	60
Mch. coarse sand	60	100
gravel	100	103
RECEIVED		
MAY 16 2003		
BY: OLWR		
Top of Lap Pipe or Reduction in Casing		
FEET	IF TELESKOPED OR MORE THAN ONE SCREEN: USE BACK PAGE	

WELL DATA

Well Depth	Casing Diameter (In.)	Casing Length (Ft.)
100	16	60
Type of Casing	Hole Depth	Depth to Static Water Level
PVC	103	
TYPE OF COMPLETION: (Circle One or More):		
Gravel Packed	Underreamed,	Telescoped,
Natural Development,	Open Hole,	Other
(Describe)		
WELL GROUTED TO A DEPTH OF 10 FEET		
Type Grout (circle one): Cement Bentonite for Mix		

SCREEN DATA

Diameter - Inches	Length - Feet	Slot Size - Inches
16	40	051
Screen Type	Depth to Bottom - Feet	
DUC	100	


I certify that the well was drilled, constructed and completed in accordance with all applicable Requirements of the Mississippi Department of Environmental Quality and/or the Mississippi Department of Health regulations and state laws.

Signature of Licensed Driller and License No.

5/13/03 Date

If well telescopes please sketch and show depths.

GROUND LEVEL

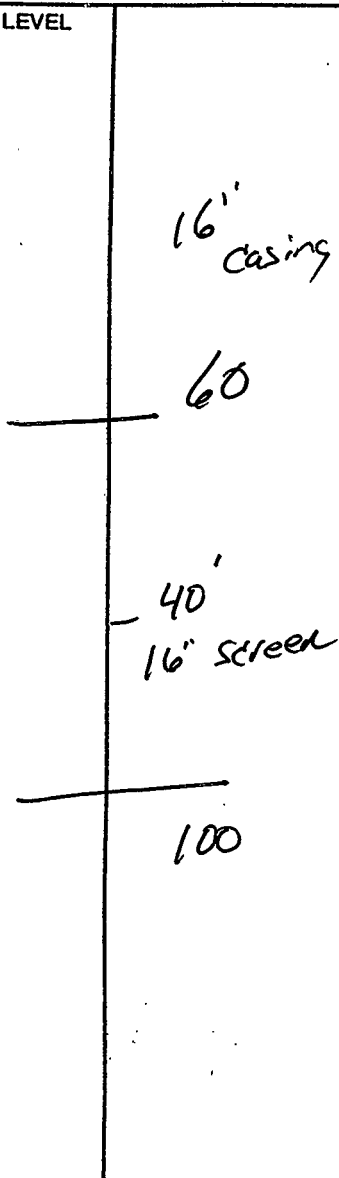

If more than one screen, show location of each on sketch.

		*	

SECTION 30

Please indicate well location X.

Pump Capacity (GPM)	No. of Stages	Setting Depth
3000	1	60 FT.

PUMP TEST

Well yielded _____ GPM with a drawdown of _____ ft. after _____ hours of pumping

LOG DATA

TYPE OF LOG RUN (Circle One): No Log Run
 Electric, Gamma Ray, Density, Sonic, Neutron, Other (Describe) _____

Name of Organization Running Log _____

GEOLOGIC DATA (Office Use Only)

Surface Elev.	Geologic Unit	Unit Thickness	Depth to Top
Subs. SWL	Date	Analysis	Aquifer Test

Driller's Remarks
