
5	prife avoid	b North well	
	State We	ell Report	
County: WASH INGOD		urt 1	For Office Use Only:
Permit #:	Mississippi Department	of Environmental Quality	Aquifer:
		nd Water Resources	Well #:67
Driller: J. NEWCOME		ox 10631 S 39289-0631	L. S. Elevation:
Date drilling completed: 4-11-07		61-5210	
	(601)354	-6938 (fax)	E-log #:
State Law requires that this rep 30 days of completion of drilling		driller in detail and filed w	ith the Department within
Well Owner Inform		Wel	1 Location
Owner Naber FTW 000 Mitication AREA		Latitude: 33 . 12 . 54	" Longitude: 090.57.51."
Mailing Address C/O CORPOFENS; DEERS		Method of Lat/Long (circle o	
4155 CLAYST-		USGS quad, Hand-held GPS Survey-grade GPS	
Vicksburg	<u>Mc. 39/03</u> tate Zip Code	·	D Twn 16N Rng TW
	- 52.83	Distance Direction	of AYON
	Well I	Jata	
Purpose of Well (circle one) Home In	dustrial Public Supply	Irrigation Fish Culture	Other:
Date well drilling started: 4- 11- 1	Date Date	well drilling completed: <u> </u>	11-07
If flowing, method of flow regulation: V	alve Other (d	escribe)	
Static Water Level:feet	above or below (circle one)	and surface Date measured	
Method of Measurement (circle one) Hole depth: Well d	· · · ·		
Type of grout (circle one): Cement	Bentonite Mix		
Casing length: 60 feet Ca	sing diameter: 10	inches Type of casing:	Pre
Screen length: 25 feet Sc			
Screen slot size:inches	s Setting depth: From _	60 feet to	SS feet
Type of completion (circle all applicable	e); Gravel nacked Under	rreamed Telescoped One	n hole Natural Development
			-
	Other (describe):		
Top of lap pipe or reduction in casing:	feet. If t	elescoped or more than one so	creen, describe on back of page
Logs run (circle all applicable): No log	run) Electric Gamma Ray	Density Sonic Neutron	Other:
Name of organization running log(s):			·
I certify that the well was drilled, con-	structed, and completed in	accordance with all applicabl	e requirements of the Mississippi
Department of Environmental Quality	y and/or the Mississippi De	partment of Health regulation	ns and state laws.
)
JOHN NEWCOME O	-773	John	kidance
Print Name of Water Well Contractor a	nd License No.	Signature	of Water Well Contractor
L			
			RECEIVE
			· · · · · · · · · · · · · · · · · · ·
•			JUL
			BY: OLV


If well telescopes please sketch below and show depths.



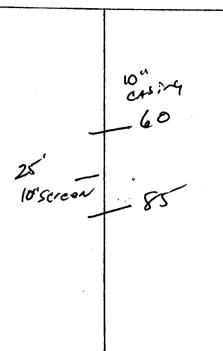

Description of Formations Encountered	From	To
700 Soil	0	10
Mix CIAY	10	38
Fine Sand	38	69
Med Conse Sand	60	K
Gray CIAY	fs	88
	·	

If more than one screen, show location of each on sketch

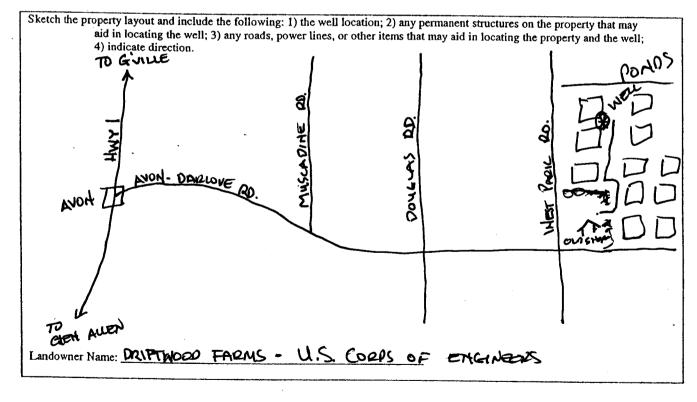

Signature of Water Well Contractor

₹.

den	STATE WE	LL REPORT	
County: LUSS H, NETON Permit #: Driller J. NEwCom SE Date completed: 4 -11-07	Part 2 Pump Installer's Completion Report Mississippi Department of Environmental Qu Office of Land and Water Resources P.O. Box 10631 Jackson, MS 39289-0631 (601)961-5210 (601)354-6938 (fax)		For Office Use Only: Aquifer: Well #: Elevation:
This report should be prepared by the installation of pump.	e pump installer in detail	and filed with the Departme	nt within 30 days of the
Well Owner Informat	,	We	Il Location
Dwner Name hiFTWOOD M	TIGATION AREA	Latitude 33-12-54	Longitude: 090-57-51
Mailing Address: Clo Corp OF	ENGINEERS	Method of Lat/Long (circle o	
		USGS quad, Han	d-held GPS, Survey-grade GPS
Viensburg, M. City State	1. 39103 Tin Code		D Twn Low Rng TW
		Distance Direction	Nearest Town
Telephone No <u>eo[)-(31-5</u>	283	4.5 Miles E	of AVON
Pump Type Circle one			ower Type
Circle one	Submersible	C	ower Type Circle one ne Engine Natural Gas
Circle one Air Lift Jet	Submersible Turbine	C	Circle one ne Engine Natural Gas
Circle one Air Lift Jet Bucket Piston		Diesel Engine Gasoli Electric Motor Hand	Circle one ne Engine Natural Gas Tractor PTO
Circle one Air Lift Jet Bucket Piston Centrifugal Rotary	Turbine	Diesel Engine Gasoli Electric Motor Hand Windmill Other	Circle one ne Engine Natural Gas Tractor PTO (specify):
Circle one Air Lift Jet Bucket Piston	Turbine Flowing Well	Diesel Engine Gasoli Electric Motor Hand Windmill Other	Circle one ne Engine Natural Gas Tractor PTO (specify): r:
Circle one Air Lift Jet Bucket Piston Centrifugal Rotary Other (specify): Date Pump Installed:7	Turbine Flowing Well	Diesel Engine Gasoli Electric Motor Hand Windmill Other Horse Power Rating of Motor	Circle one ne Engine Natural Gas Tractor PTO (specify):
Circle one Air Lift Jet Bucket Piston Centrifugal Rotary Other (specify): Date Pump Installed:7	Turbine Flowing Well	Diesel Engine Gasoli Electric Motor Hand Windmill Other Horse Power Rating of Motor Setting Depth: 20 Number of Stages: _/	Circle one ne Engine Natural Gas Tractor PTO (specify):
Circle one Air Lift Jet Bucket Piston Centrifugal Rotary Other (specify): Date Pump Installed: Rated Pump Capacity: Pump Test Data	Turbine Flowing Well Gallons Per Minute	Diesel Engine Gasoli Electric Motor Hand Windmill Other Horse Power Rating of Motor Setting Depth: 20 Number of Stages: 1	Circle one ne Engine Natural Gas Tractor PTO (specify): r:feet
Circle one Air Lift Jet Bucket Piston Centrifugal Rotary Other (specify): Date Pump Installed: Rated Pump Capacity: Pump Test Data Date Well Tested:	Turbine Flowing Well Gallons Per Minute	Diesel Engine Gasoli Electric Motor Hand Windmill Other Horse Power Rating of Motor Setting Depth: 20 Number of Stages: 1 Method of M G Air Line Electric Me	Circle one Ine Engine Natural Gas Tractor PTO (specify): (specify): r:feetfeetfeetfeet Circle one asuring Water Level Circle one Steel Tape
Circle one Air Lift Jet Bucket Piston Centrifugal Rotary Date Pump Installed: $4 - 12 - 07$ Rated Pump Capacity: 900 Pump Test Data Date Well Tested:Fee Static Water Level (A):Fee	Turbine Flowing Well Gallons Per Minute	Diesel Engine Gasoli Electric Motor Hand Windmill Other Horse Power Rating of Motor Setting Depth: 20 Number of Stages: 1	Circle one ne Engine Natural Gas Tractor PTO (specify): r:feetfeetfeet Circle one asuring Water Level Circle one Steel Tape
Circle one Air Lift Jet Bucket Piston Centrifugal Rotary Dther (specify): Date Pump Installed: Rated Pump Capacity: Pump Test Data Date Well Tested: Static Water Level (A):Feel Pumping Water Level (B)	Turbine Flowing Well Gallons Per Minute	Diesel Engine Gasoli Electric Motor Hand Windmill Other Horse Power Rating of Motor Setting Depth: 20 Number of Stages: 1 Method of M C Air Line Electric Me Other (specify):	Circle one ne Engine Natural Gas Tractor PTO (specify): r:feetfeetfeet Circle one asuring Water Level Circle one Steel Tape
Circle one Air Lift Jet Bucket Piston Centrifugal Rotary Other (specify): Date Pump Installed:7 Rated Pump Capacity:7 Pump Test Data Date Well Tested: Static Water Level (A):Feel Pumping Water Level (B)	Turbine Flowing Well Gallons Per Minute Below Land Surface Below Land Surface	Diesel Engine Gasoli Electric Motor Hand Windmill Other Horse Power Rating of Motor Setting Depth: 20 Number of Stages: 1 Method of M C Air Line Electric Me Other (specify): For flowing well, measured s	Circle one Natural Gas Tractor PTO (specify): (specify): r:feetfeetfeetfeetfeet Circle one asuring Water Level Circle one Steel Tape

I HEREBY CERTIFY that the above statements are true to the best of my knowledge	
(HEN Rom #710 R	The second secon
the pue no-	in pices
Print Name of Pump Installer and License No. (if applicable) Sign	ature of Pump Installer

JUL 1 0 2007 BY: OLWR