

BRADON
State Well Report
Part 1

Mississippi Department of Environmental Quality
Office of Land and Water Resources
P.O. Box 10631
Jackson, MS 39289-0631
(601)961-5210
(601)354-6938 (fax)

For Office Use Only:

Aquifer: _____
Well #: L-172
L. S. Elevation: _____
E-log #: _____

County: WASHINGTON
Permit: 60042243
Driller: J. NEWCOME 0-773
Date drilling completed: 11-7-07

State Law requires that this report be prepared by the driller in detail and filed with the Department within 30 days of completion of drilling of the well.

Well Owner Information	Well Location
Owner Name: <u>BRADON Farms Inc.</u>	Latitude: <u>33° 14' 43"</u> Longitude: <u>090° 53' 26"</u>
Mailing Address: <u>P.O. Box 522</u>	Method of Lat/Long (circle one): <u>Hand-held GPS</u> Conventional Survey
<u>HOLLANDALE, MS</u> ³⁸⁷⁴⁸	USGS quad: <u>SE 1/4 14 1/4 Sec 14 Twn 16N Rng 7W</u>
City State Zip Code	Distance Direction of Nearest Town
Telephone: <u>662-820-8555</u>	<u>1.5</u> Miles <u>S</u> of <u>ARCOLA</u>

Well Data

Purpose of Well (circle one) Home Industrial Public Supply Irrigation Fish Culture Other: _____

Date well drilling started: 11-7-07 Date well drilling completed: 11-07-07

If flowing, method of flow regulation: Valve _____ Other (describe) _____

Static Water Level: _____ feet above or below (circle one) land surface Date measured: _____

Method of Measurement (circle one) steel tape electric tape air line other: _____

Hole depth: 103 Well depth: 100 Well grouted to a depth of 10 feet

Type of grout (circle one): Cement Bentonite Mix

Casing length: 70 feet Casing diameter: 16 inches Type of casing: P.V.C.

Screen length: 30 feet Screen diameter: 16 inches Type of screen: P.V.C.

Screen slot size: .050 inches Setting depth: From 70 feet to 100 feet

Type of completion (circle all applicable): Gravel packed Underreamed Telescoped Open hole Natural Development

Other (describe): _____

Top of lap pipe or reduction in casing: _____ feet. If telescoped or more than one screen, describe on back of page

Logs run (circle all applicable): No log run Electric Gamma Ray Density Sonic Neutron Other: _____

Name of organization running log(s): _____

I certify that the well was drilled, constructed, and completed in accordance with all applicable requirements of the Mississippi Department of Environmental Quality and/or the Mississippi Department of Health regulations and state laws.

JOHN NEWCOME 0-773
Print Name of Water Well Contractor and License No.


John Newcome
Signature of Water Well Contractor

Pump HAS NOT BEEN INSTALLED
YET. WILL SEND PART 2
VAEN.

RECEIVED
DEC 10 2007
BY: OLWR

L -


If well telescopes please sketch below and show depths.

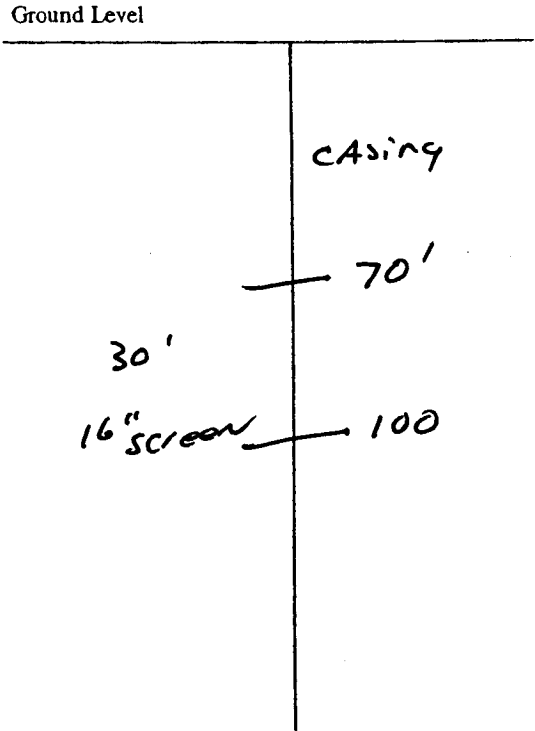

Description of Formations Encountered	From	To
TOP Soil	0	10
Mix Clay	10	38
Fine Sand	38	70
Coarse Sand-gravel mix	70	103

If more than one screen, show location of each on sketch

Sketch the property layout and include the following: 1) the well location; 2) any permanent structures on the property that may aid in locating the well; 3) any roads, power lines, or other items that may aid in locating the property and the well; 4) indicate direction.

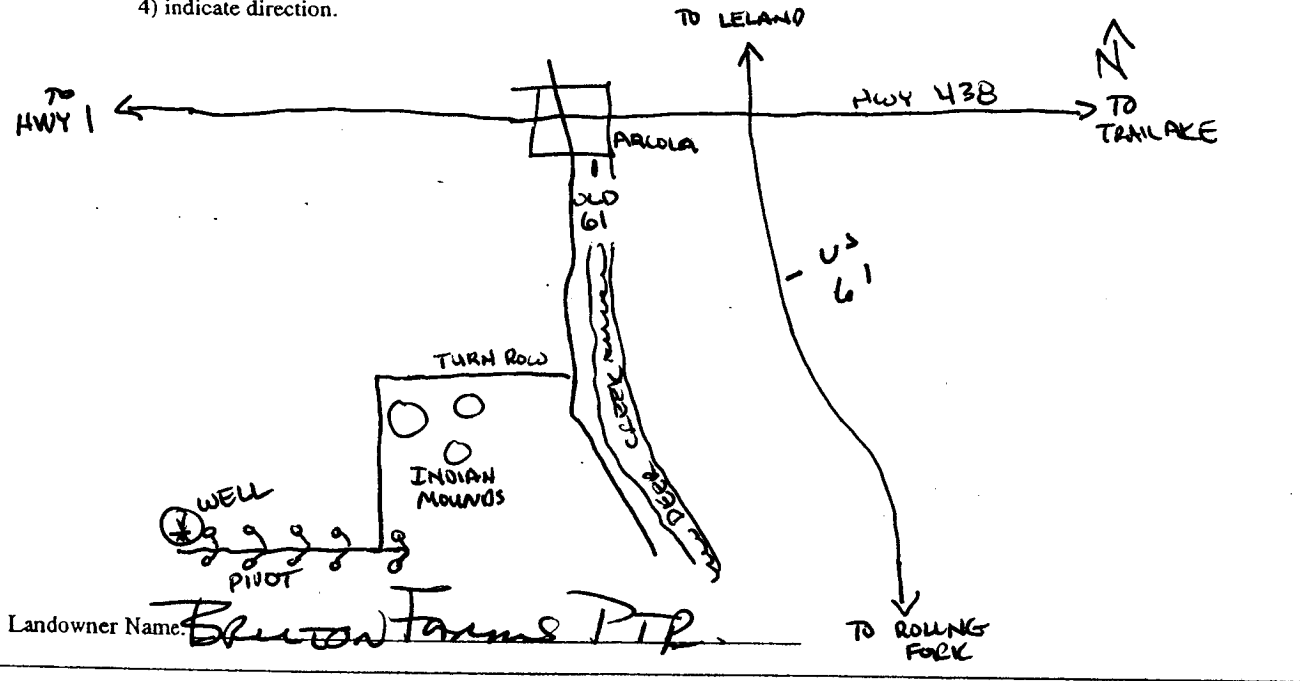

Signature of Water Well Contractor
J. D. Newman

STATE WELL REPORT *Pivot well*

Part 2

Pump Installer's Completion Report
 Mississippi Department of Environmental Quality
 Office of Land and Water Resources
 P.O. Box 10631
 Jackson, MS 39289-0631
 (601)961-5210
 (601)354-6938 (fax)

County: WASHINGTON
 Permit #: 6W42243
 Driller: J. NEWCOMB 60-773
 Date completed: 11-7-07

For Office Use Only:

Aquifer: _____
 Well #: L-172
 Elevation: _____

This report should be prepared by the pump installer in detail and filed with the Department within 30 days of the installation of pump.

Well Owner Information

Owner Name: Brueton Farms Pte.
 Mailing Address: PO Box 522
HOLLANDALE MS 38748
 City State Zip Code
 Telephone No: 662-820-8555

Well Location

Latitude: 33-14-43 Longitude: 090-53-263
 Method of Lat/Long (circle one): 26 Conventional Survey, 16
 USGS quad, Hand-held GPS Survey-grade GPS
~~SE~~ NE ~~NW~~ NE Sec 14 Twn 16N Rng 7W
 Distance Direction Nearest Town
1.5 Miles S of ARCOLA

Pump Type
Circle one

Air Lift Jet Submersible
 Bucket Piston Turbine
 Centrifugal Rotary Flowing Well
 Other (specify): _____
 Date Pump Installed: 12-8-08
 Rated Pump Capacity: 1500 Gallons Per Minute

Power Type
Circle one

Diesel Engine Gasoline Engine Natural Gas
 Electric Motor Hand Tractor PTO
 Windmill Other (specify): _____
 Horse Power Rating of Motor: 80
 Setting Depth: 70 feet
 Number of Stages: 4

Pump Test Data

Date Well Tested: _____
 Static Water Level (A): _____ Feet Below Land Surface
 Pumping Water Level (B): NO TEST Feet Below Land Surface
 Drawdown [(B) - (A)]: _____ Feet Below Land Surface
 Test Pumping Rate: _____ Gallons Per Minute
 Duration of Pump Test (minimum 4 hours): _____ hours

Method of Measuring Water Level
Circle one

Air Line Electric Measuring Line Steel Tape
 Other (specify): _____
 For flowing well, measured shut in head: _____ feet
 Well yielded _____ GPM with a drawdown of _____ feet after _____ hours of pumping

I HEREBY CERTIFY that the above statements are true to the best of my knowledge.
GLEN ROWE 7107 Glen Rowe
 Print Name of Pump Installer and License No. (if applicable) Signature of Pump Installer

WELL PART #1 PREVIOUSLY SUBMITTED

RECEIVED
 APR 10 2008
 BY: OLWR