

State Well Report

Part 1

Mississippi Department of Environmental Quality
Office of Land and Water Resources
P.O. Box 10631
Jackson, MS 39289-0631
(601)961-5210
(601)354-6938 (fax)

County: Washington
Permit #: 0042438
Irrigation Equipment
Driller: _____
Date drilling completed: 6-1-08

For Office Use Only:
Aquifer: _____
Well #: L-177
L. S. Elevation: _____
E-log #: _____

State Law requires that this report be prepared by the driller in detail and filed with the Department within 30 days of completion of drilling of the well.

Well Owner Information	Well Location
Owner Name: <u>Steele Farms</u>	Latitude: <u>33° 14' 57.5"</u> Longitude: <u>90° 56' 25.9"</u>
Mailing Address: <u>40 Riverside Road</u>	Method of Lat/Long (circle one): <u>57</u> Conventional Survey, <u>26</u>
<u>Hollandale Ms. 38748</u>	USGS quad, Hand-held GPS, Survey-grade GPS
City State Zip Code	<u>NE 1/4 SE 1/4 Sec 8 Twn 16N Rng 7W</u>
Telephone No. () _____	Distance Direction Nearest Town <u>3</u> Miles <u>SW</u> of <u>Arcola</u>
Well Data <u>old well 15' south</u>	
Purpose of Well (circle one) Home Industrial Public Supply <u>Irrigation</u> Fish Culture <u>Other replacement</u>	
Date well drilling started: <u>6-1-08</u> Date well drilling completed: <u>6-1-08</u> <u>0041163</u>	
If flowing, method of flow regulation: Valve _____ Other (describe) _____	
Static Water Level: <u>29</u> feet above or <u>below</u> (circle one) land surface Date measured: <u>6-2-08</u>	
Method of Measurement (circle one) <u>steel tape</u> electric tape air line other: _____	
Hole depth: <u>95</u> Well depth: <u>95</u> Well grouted to a depth of <u>10</u> feet	
Type of grout (circle one): Cement <u>Bentonite</u> Mix	
Casing length: <u>60</u> feet Casing diameter: <u>16</u> inches Type of casing: <u>PVC</u>	
Screen length: <u>35</u> feet Screen diameter: <u>16</u> inches Type of screen: <u>PVC</u>	
Screen slot size: <u>.050</u> inches Setting depth: From <u>61</u> feet to <u>95</u> feet	
Type of completion (circle all applicable): <u>Gravel packed</u> Underreamed Telescoped Open hole Natural Development	
Other (describe): _____	
Top of lap pipe or reduction in casing: _____ feet. If telescoped or more than one screen, describe on back of page	
Logs run (circle all applicable): <u>No log run</u> Electric Gamma Ray Density Sonic Neutron Other: _____	
Name of organization running log(s): _____	
I certify that the well was drilled, constructed, and completed in accordance with all applicable requirements of the Mississippi Department of Environmental Quality and/or the Mississippi Department of Health regulations and state laws.	
Irrigation Equipment Inc Patrick M. Chism 0695	
Print Name of Water Well Contractor and License No.	Signature of Water Well Contractor

RECEIVED
JUN 05 2008
BY: OLWR

STATE WELL REPORT

Part 2

Pump Installer's Completion Report
 Mississippi Department of Environmental Quality
 Office of Land and Water Resources
 P.O. Box 10631
 Jackson, MS 39289-0631
 (601)961-5210
 (601)354-6938 (fax)

County: Washington
 Permit #: 0040538
 Irrigation Equipment
 Driller: _____
 Date completed: 6-1-08

For Office Use Only:

Aquifer: _____
 Well #: L-177
 Elevation: _____

This report should be prepared by the pump installer in detail and filed with the Department within 30 days of the installation of pump.

Well Owner Information	Well Location
Owner Name: <u>Steele Farms</u> Mailing Address: <u>40 Riverside Road</u> <u>Hollandale Ms. 38748</u> <small>City State Zip Code</small> Telephone No. () _____	Latitude: _____ Longitude: _____ Method of Lat/Long (circle one): Conventional Survey, USGS quad, Hand-held GPS, Survey-grade GPS <u>NE 1/4 SE 1/4 Sec 8 Twn 16N Rng 7W</u> Distance Direction Nearest Town <u>3 Miles SW of Arcola</u>


Pump Type Circle one	Power Type Circle one
Air Lift Jet Submersible Bucket Piston Turbine Centrifugal Rotary Flowing Well Other (specify): _____ Date Pump Installed: <u>6-2-08</u> Rated Pump Capacity: <u>1800±</u> Gallons Per Minute	Diesel Engine Gasoline Engine Natural Gas Electric Motor Hand Tractor PTO Windmill Other (specify): _____ Horse Power Rating of Motor: <u>40</u> Setting Depth: <u>70</u> feet Number of Stages: <u>2</u>

Pump Test Data	Method of Measuring Water Level Circle one
Date Well Tested: _____ Static Water Level (A): _____ Feet Below Land Surface Pumping Water Level (B): _____ Feet Below Land Surface Drawdown [(B) - (A)]: _____ Feet Below Land Surface Test Pumping Rate: _____ Gallons Per Minute Duration of Pump Test (minimum 4 hours): _____ hours	Air Line Electric Measuring Line Steel Tape Other (specify): _____ For flowing well, measured shut in head: _____ feet Well yielded _____ GPM with a drawdown of _____ feet after _____ hours of pumping

I HEREBY CERTIFY that the above statements are true to the best of my knowledge.

Patrick M. Chism 0695
 Print Name of Pump Installer and License No. (if applicable) Signature of Pump Installer

RECEIVED
 JUN 05 2008
 BY: OLWR

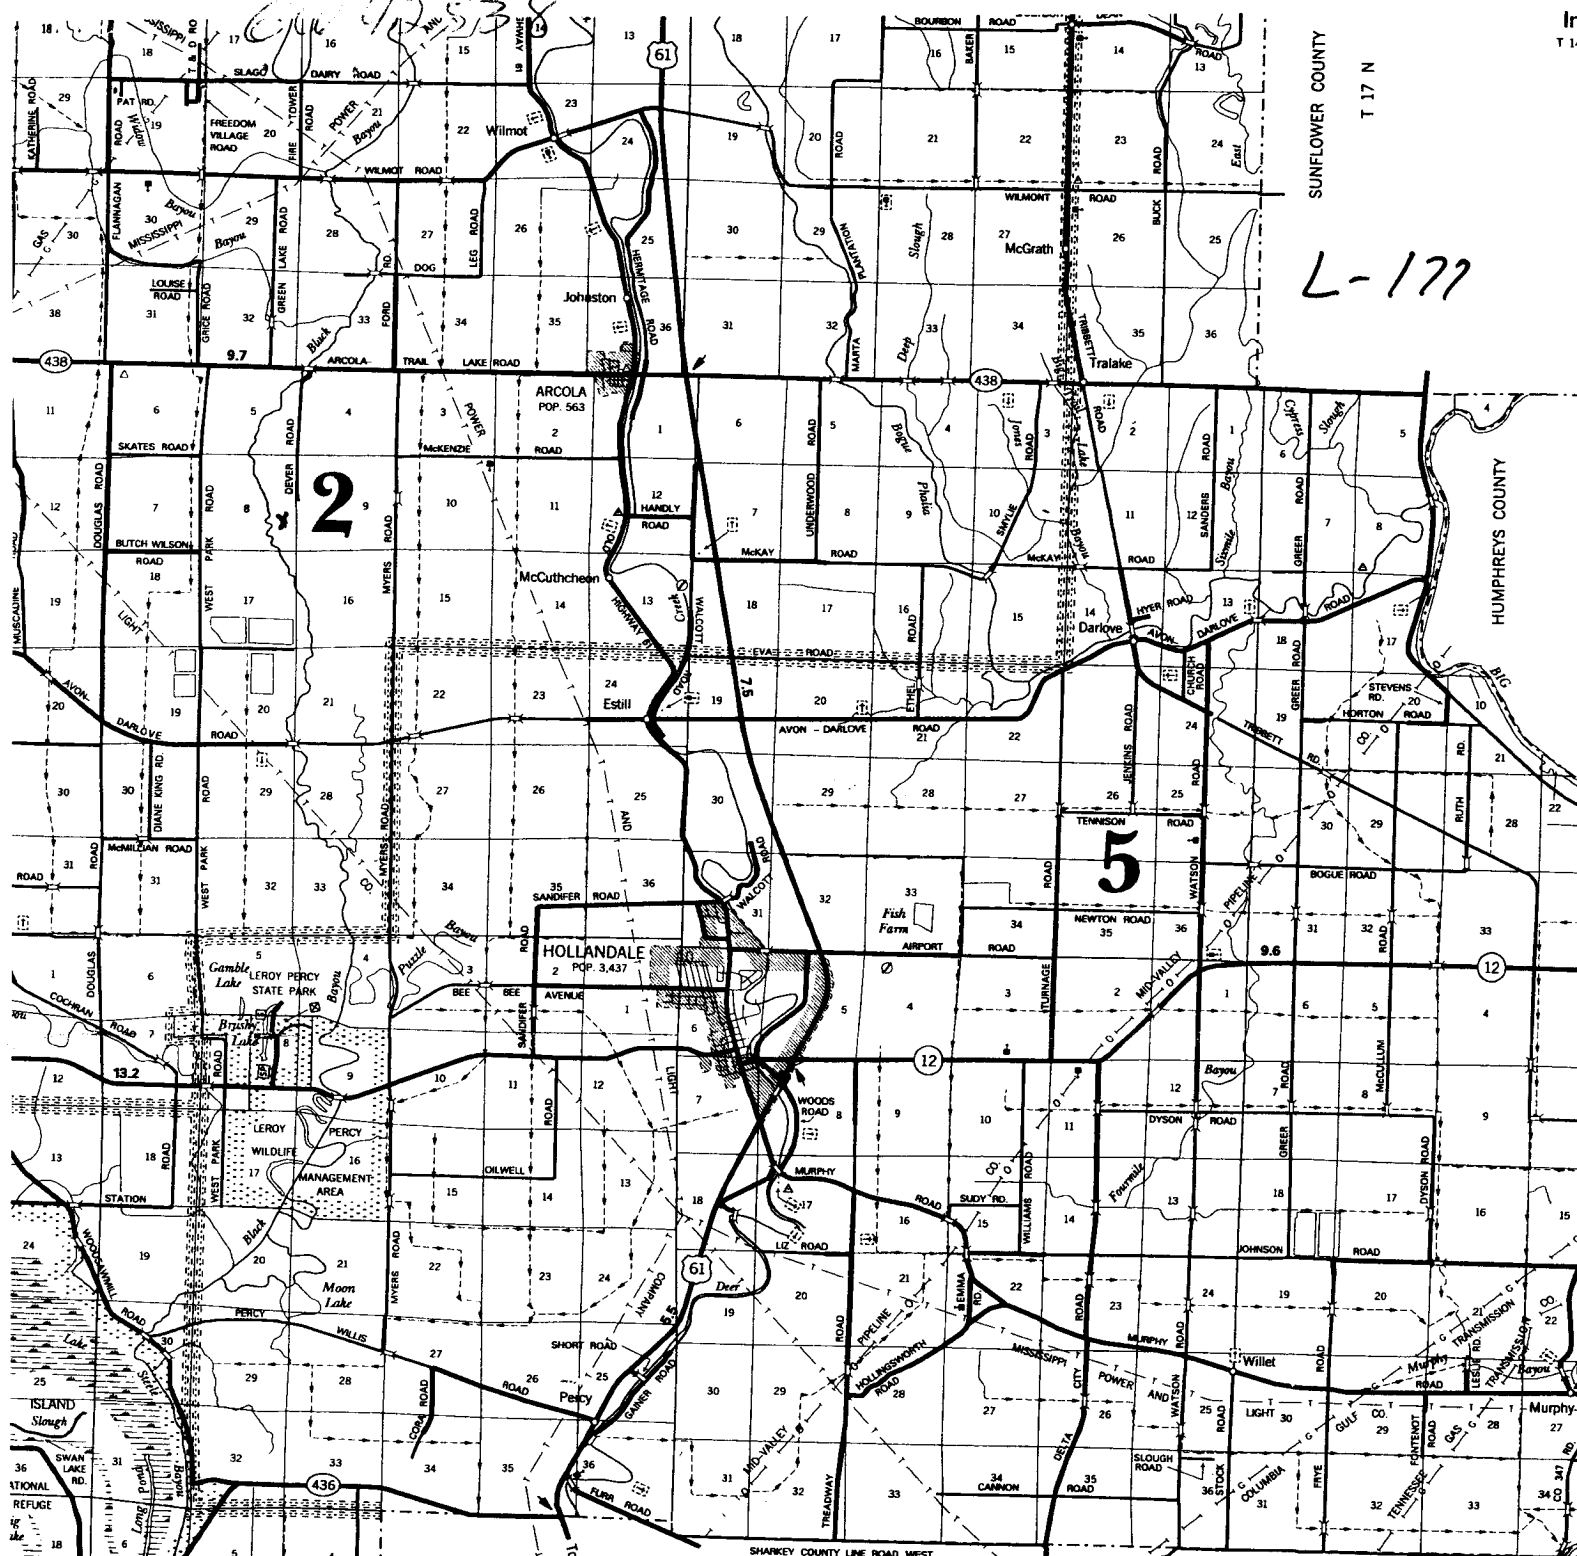

Steele Farms Map

LEGEND

- | | | | |
|----------------------------|-------|---------------------------|-------|
| ROADS AND ROADWAY FEATURES | | NAVIGATION | |
| UNIMPROVED ROAD | ----- | DOCK, PIER, OR LANDING | ----- |
| GRAVEL | ----- | LEVEE OR DIKE | ===== |
| PAVED ROAD | ===== | LEVEE OR DIKE WITH ROAD | ===== |
| UNDIVIDED HIGHWAY | ===== | | |
| DIVIDED HIGHWAY | ===== | | |
| INTERSTATE SYSTEM | ===== | | |
| CITY STREETS | ===== | | |
| HIGHWAY BRIDGES | | CITY AND VILLAGE CENTERS | |
| BRIDGE 50 FEET AND OVER | ----- | CITY SEAT | ----- |
| DRAWBRIDGE | ----- | OTHER CITIES AND VILLAGES | o |
| FERRY (FREE OR TOLL) | ----- | | |
| HIGHWAY GRADE SEPARATION | ----- | MISCELLANEOUS | |
| HIGHWAY INTERCHANGE | ----- | TRIANGULATION STATION | ----- |
| | | BENCH MARK WITH ELEVATION | ----- |

RECEIVED
 JUN 05 2008
 BY: OLWF
 2124