

Lakehurst Plantation

MISSISSIPPI DEPARTMENT OF ENVIRONMENTAL QUALITY

Office of Land and Water Resources

P. O. Box 10631

Jackson, MS 39289-0631

WATER WELL DRILLERS LOG

COUNTY WELL LOCATED	Washington
WELL NUMBER	L196
DATE WELL COMPLETED	6-4-02

PERMIT NUMBER	GW39037
NAME OF DRILLING FIRM	Chicot Irrigation

NAME & MAILING ADDRESS OF LANDOWNER	LERoy PLANTATION 1169 AVON-DARLOVE RD. HOLLANDALE, MS. 38748
Latitude	33 12 67 40
Longitude	090 54 79 47
WELL LOCATION	NW/NW 27 v. 16 S 7 E
DISTANCE	7 Miles East of AVON
OTHER LANDMARK	
WELL PURPOSE: Home, Municipal, Industrial, Fish Pond, etc.	Home, Irrigation

PUMP DATA		
PUMP TYPE (Circle One):	Submersible, Turbine, Jet	Flowing Well, Other (Describe)
POWER TYPE (Circle One):	Electric, Tractor, Diesel, Gasoline, Butane, Other (Describe)	H/P 60
DESCRIPTION OF FORMATIONS ENCOUNTERED	FROM	TO
Top Soil	0	10
Blue Clay	10	40
Fine Sand	40	60
Med. Coarse Sand	60	70
Fine Sand	70	95
Coarse Sand	95	105
med. Sand.	105	105
<b>RECEIVED</b>		
JUN 10 2002		
Dept. of Environmental Quality Office of Land & Water Resources		
Top of Lap Pipe or Reduction in Casing		
FEET	IF TELESCOPED OR MORE THAN ONE SCREEN: USE BACK PAGE	


WELL DATA		
Well Depth	Casing Diameter (In.)	Casing Length (Ft.)
105	16	65
Type of Casing	Hole Depth	Depth to Static Water Level
PVC	108	
TYPE OF COMPLETION: (Circle One or More):		
Gravel Packed, Underreamed, Telescoped, Natural Development, Open Hole, Other (Describe)		
WELL GROUTED TO A DEPTH OF FEET		
Type Grout (circle one): Cement, Bentonite, or Mix		

SCREEN DATA		
Diameter - Inches	Length - Feet	Slot Size - Inches
16	40	051
Screen Type	Depth to Bottom - Feet	
PVC	110	

I certify that the well was drilled, constructed and completed in accordance with all applicable Requirements of the Mississippi Department of Environmental Quality and/or the Mississippi Department of Health regulations and state laws.

Signature of Licensed Driller and License No. James A. McDonald Date 6/5/02

If well telescopes please sketch and show depths.

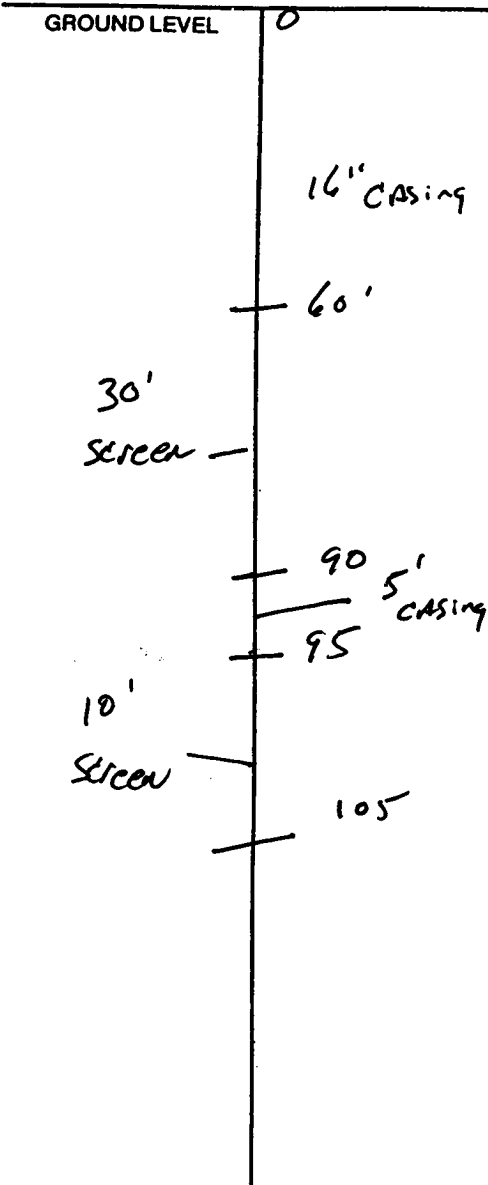

			X

SECTION 27

Please indicate well location X.

Pump Capacity (GPM)	No. of Stages	Setting Depth	FT.
PUMP TEST			
Well yielded _____ GPM with			
a drawdown of _____ ft.			
after _____ hours of pumping			

LOG DATA

TYPE OF LOG RUN (Circle One): No Log Run  
 Electric, Gamma Ray, Density, Sonic, Neutron,  
 Other (Describe) \_\_\_\_\_

Name of Organization Running Log \_\_\_\_\_

GEOLOGIC DATA (Office Use Only)

Surface Elev.	Geologic Unit	Unit Thickness	Depth to Top
Subs. SWL	Date	Analysis	Aquifer Test

Driller's Remarks

\_\_\_\_\_

\_\_\_\_\_

If more than one screen, show location of each on sketch.