.

1.4

STATE WELL REPORT					
Part 1 For Office Use Only:					
Driller's Log Well #: $-\frac{1}{200}$					
MISSISSIDDI DEDALLINETIL UL LINNOTTHETILAL QUALITY I					
Date drilling completed: 1.30.1.2 Jackson, MS 39225-2309					
(601)961-5210 (601)961-5210 (601)360-0535 (fax)					
State Law requires that this report be prepared by the license holder responsible for the work and filed with the					
Department at the above address within 30 days of completion of drilling of the well or borehole.					
Well Owner Information Well or Borehole Location					
(Landowner if borehole is not for a water well) Latitude: <u>23°14′17</u> Longitude: <u>90°5710</u>					
lowner Name: Hobart Brothers tarm					
Mailing Address: 160 Butchwilson Rol Method of Lat/Long (check one): Conventional Survey,					
USGS quad, Hand-held GPS, Survey-grade GPS					
Hollandele MS 38748 NW 4, Sec 17 T 16N R 07W					
City State Zip Code 5 Miles S.W. of ARCOLA					
Telephone No. () (Distance) (Direction) (Nearest Town)					
Well / Borehole Data					
Well / Borehole Data Date drilling started: $7.30.13$ Date drilling completed: $7.30.13$ Hole depth: B Hole diameter: 24^{11}					
Location of the source of any surface water used for drilling: DTCH					
Method of dosing and volume of Chlorine used in drilling and development: CHLORINE TABLET					
Logs run (circle all applicable): No tog run Electric Gamma Ray Density Sonic Neutron Other:					
Name of organization running log(s):					
Purpose of borehole (circle one) Water Well Geotechnical/Geological Investigation Ground Source Heat Pump					
Seismic Survey Other (<i>describe</i>)					
If drilling is not related to water well construction, skip the remainder of this block					
Purpose of Well (circle all applicable): Home Industrial Public Supply Trigation Fish Culture					
Other (describe):					
If a flowing well, method of flow regulation: Valve Other (<i>describe</i>)					
Static Water Level:feet [above or below] land surface Date measured: (circle one)					
Method of measurement (circle one): Steel tape Electric tape Air line Other (describe):					
Well depth: 18 Well grouted to a depth of: 10 feet Type of grout (circle one): Neat Cement Bentonite Mix					
Casing length: <u>50</u> feet Casing diameter: <u>16</u> inches Type of casing: <u>P.V.C.</u>					
Screen length: <u>28</u> feet Screen diameter: <u>16</u> inches Type of screen: <u>P-V.C.</u>					
Screen slot size: 3.050 inches Setting depth: From <u>50</u> feet to <u>78</u> feet					
Type of completion (circle all applicable): Gravel packed Underreamed Open hole Natural Development					
Other (describe):					
Top of lap pipe or reduction in casing:feet					
If telescoped or more than one screen, describe on next page					

Form: OLWR-SWR-1A (4/13)


County:	Washington
Permit #:	GW47027

	Fo	r Oi	fice	Use	Only:	
Vell	#:	L	20]		

The sketch below only required for water wells

Description of formations encountered must be provided for all wells and boreholes, unless specifically exempted by regulations

If well telescopes, show depths on sketch.

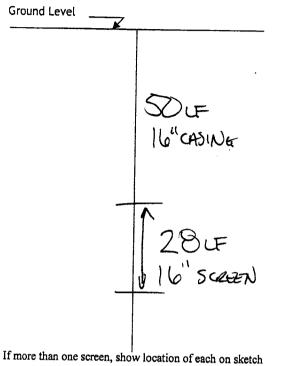

Description of Formations Encountered	From (depth)	To (depth)
TOP SOIL	Ground level	10
CLAY	10	25
SAND	25	50
FAUR SAND	50	53
MODIUM SAND	53	<u>_58</u>
MEQUIN FAVE	58	<u>(a)</u>
CLAT	61	
Bottom	10	10
		01
	++	
		······
	<u> </u>	
	+	
	<u> </u>	

Sketch the property layout and include the following:

1) the well location

2) any permanent structures on the property that may aid in locating the well

3) any roads, power lines, or other items that may aid in locating the property and the well 4) north arrow

Landowner Name:

I HEREBY CERTIFY that the well/borehole was drilled, constructed, and completed in accordance with all applicable requirements of the Mississippi Department of Environmental Quality and the Mississippi Department of Health regulations, if applicable, and state laws.

Date

JOHN 1	ENCOME	0.7-	13	7
Print Name o	f Responsible Li	censee and	icense No	<u> </u>

Form: OLWR-SWR-1A (4/13)

Signature of Licensee

x .	STATE W	ELL REPORT		
County: Washington]	Part 2	For Office Use Only:	
Permit #: 6W-49027		r's Completion Report	Well #:	
Driller: J. New Come 0-773	Office of Land and Water Resources			
Date completed: 7-30-13		.O. Box 2309 n, MS 39225-2309	Aquifer:	
Copy information from block on Part 1	(6	01)961-5210		
	•) 360-0535 (fax)	·····	
This part of the report must be complete of the report must be attached and both	ed by a licensed water parts filed with the D	well contractor or a licensed pur enartment at the above address w	np installer. A copy of Part 1 vithin 30 days of well completion.	
Well Owner Informat			ocation	
Owner Name: Hobart Brother		Latitude: <u>33 14 17</u> Lon		
Mailing Address: 160 Butch	<u>n li Ison Ka</u>			
	······	USGS quad, Hand-held G	PS_X, Survey-grade GPS	
Hullanfale MS City State	<u> </u>	NW 1/4 NW 1/4, Sec_	17 T16NR 070	
	-	5_Miles S.W. o	f Arcola (Nearest Town)	
Telephone No. ()		(Distance) (Direction)	(Nearest Town)	
	Pump Ty	De (c ircle one)		
Submersible Turbine Air Lift Centri	fugal Flowing Well	Jet Piston Rotary Other (de	scribe):	
Date Pump Installed: <u>3-1-</u>	13 1	Rated Pump Capacity: <u>700</u>	Gallons Per Minute	
Is This Pump (circle one): Re	paired Replaceme	nt		
6	•	p e (c ircle one)		
Electric Diesel Gasoline Natural Ga	-			
Horse Power Rating of Motor: 25	Setting Dept	h:feet Number	of Stages:	
Pump Test Data for Non Flowing Well Date Well Tested:				
Method of measurement (circle one): S	Steel tape Electric t	ape Air line Other (describe):		
Measured shut in head:				
	A Meter	Installation		
Meter Manufacturer:				
Installation Date: Meter installed by:				
Installation Date: Meter installed by: Is This Meter (<i>circle one</i>): New Repaired Replacement				
Important: Ry submitting the above	information vou are c		alled to manufacturer standards. vebsite.	
			<u>, </u>	
I HEREBY CERTIFY that the above state Hubbard Stephen Print Name of Pump Installed and Lice	5 741-1	8-26-13 Aml	ature of Pump Installer	
Franc Marie of Fullip instance, and Lice	inse tto, (i) uppricubit	., vate visit	Form: OLWR-SWR-2A (4/1	

,