

Washington
 L 1001
 12-5-79

MISSISSIPPI
 BOARD OF WATER COMMISSIONERS
 416 North State Street
 Jackson, Mississippi 39201

WATER WELL DRILLERS LOG

12-5 date well completed 1979 Larry's Well & Pump firm name Washington county well located

LANDOWNER: Conagra
Box 100 Tippa Miss
 (mailing address)

description of formations encountered	from	to
clay	0'	18'
thin coarse sand	18'	40'
thin coarse sand & gravel	40'	85'
clay	85'	97'

WELL LOCATION:
 sec. 19 T 16 N R-7 E
6 miles West of Estell
 (distance) (direction) (nearest town)

WELL PURPOSE: Fish Pond
 (home, irrigation, municipal, industrial)


- WELL COMPLETION DATA:
- (1) diameter (inches) 12"
 - (2) total depth (feet) 95'
 - (3) static water level (feet) 10' ^{below} above top of ground.
 - (4) casing Steel 55'
 (material) (depth)
 (size) if telescope see back.
 - (5) screen 40' 55'
 (length) (depth to top)
12" steel
 (size) (material)
 - (6) pump 30 1200
 (HP) (yield gpm)
Electric
 (type power)
 - (7) electric log (yes or no)
 - (organization running log)
 - (8) how well bottom plugged steel plate

DRILLERS REMARKS:

DEPT. OF NATURAL RESOURCES
 BUREAU OF LAND & WATER RESOURCES
 DEC 13 1979
 RECEIVED

If well telescopes please sketch and show depths.

GROUND LEVEL

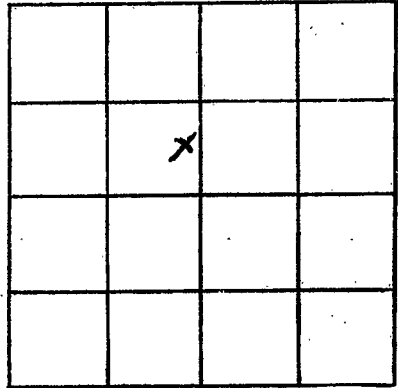

SECTION 6

Please indicate well location X.

ADDITIONAL INFORMATION

If more than one screen,
show locations of each on sketch.