

Washington  
L 1002  
5-13-80

MISSISSIPPI  
BOARD OF WATER COMMISSIONERS  
416 North State Street  
Jackson, Mississippi 39201

WATER WELL DRILLERS LOG

April 5 1980 Larry's Well & Pump Washington  
date well completed firm name county well located

LANDOWNER: Virgil Sandifer  
Hollandale, Ms

(mailing address)

WELL LOCATION: NE NW  
sec. 35 T 16 N R 7 E  
S W  
1 1/2 miles W of Hollandale  
(distance) (direction) (nearest town)

WELL PURPOSE: irrigation  
(home, irrigation, municipal, industrial)

WELL COMPLETION DATA:

- (1) diameter (inches) 16"
- (2) total depth (feet) 114'
- (3) static water level (feet) 18' <sup>below</sup> <sub>above</sub> top of ground.
- (4) casing steel, 74'  
(material) (depth)
- (size) if telescope see back.
- (5) screen 40', 74'  
(length) (depth to top)
- 16", steel  
(size) (material)
- (6) pump 60, 3000  
(HP) (yield gpm)

(type power)

(7) electric log No  
(yes or no)

(organization running log)

(8) how well bottom plugged steel plate

DRILLERS REMARKS:

description of formations encountered	from	to
<u>clay</u>	<u>0'</u>	<u>21'</u>
<u>fine sand</u>	<u>21'</u>	<u>40'</u>
<u>very coarse sand</u>	<u>40'</u>	<u>75'</u>
<u>coarse sand &amp; silt/clay</u>	<u>75'</u>	<u>114'</u>


DEPT. OF NATURAL RESOURCES  
BUREAU OF LAND & WATER RESOURCES

MAY 12 1980

RECEIVED

If well telescopes please sketch and show depths.

GROUND LEVEL

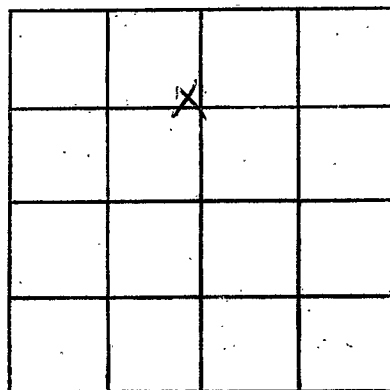

SECTION 30

Please indicate well location X.

ADDITIONAL INFORMATION

If more than one screen, show locations of each on sketch.