

Washington
 L1063
 5-13-80

MISSISSIPPI
 BOARD OF WATER COMMISSIONERS
 416 North State Street
 Jackson, Mississippi 39201

WATER WELL DRILLERS LOG

#2

FEB 27 1980 Harris Well Pump Washington
 date well completed firm name county well located

LANDOWNER: Buddy Cochran	description of formations encountered	from	to
(mailing address)	Clay	0	18'
WELL LOCATION: sec. 31 T 16 N R 7 E 7 1/2 miles W of Hollandale	fine sand	18'	36'
(distance) (direction) (nearest town)	med sand	36'	52'
WELL PURPOSE: (home, irrigation, municipal, industrial)	coarse sand	52'	85'
WELL COMPLETION DATA:	coarse sand + siltstone	85'	114'
(1) diameter (inches) 16"			
(2) total depth (feet) 115'			
(3) static water level (feet) 17' ⁶⁶ above top of ground.			
(4) casing Steel, 75' (material) (depth) (size) if telescope see back.			
(5) screen 40, 75' (length) (depth to top)			
16" Steel (size) (material)			
(6) pump 1.0, 3000 (HP) (yield gpm)			
(type power)			
(7) electric log No (yes or no)			
(organization running log)			
(8) how well bottom plugged Steel plate			
DRILLERS REMARKS:			

DEPT. OF NATURAL RESOURCES
 BUREAU OF LAND & WATER RESOURCES


MAY 19 1980

RECEIVED

If well telescopes please sketch and show depths.

N

GROUND LEVEL

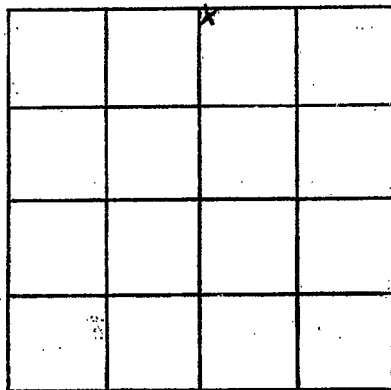

SECTION 31

Please indicate well location X.

ADDITIONAL INFORMATION

If more than one screen, show locations of each on sketch.