

Washington
L 2001
7/17/76

MISSISSIPPI
BOARD OF WATER COMMISSIONERS
416 North State Street
Jackson, Mississippi 39201

WATER WELL DRILLERS LOG

July 17 1976 Schultz Drilling Washington
date well completed firm name county well located

LANDOWNER: W.E. Hughes

Rt 2.

GREENVILLE MISS

(mailing address)

WELL LOCATION:

sec. 18 T. 16 N. R. 7 E. W. 1
10 miles S of Greenville
(distance) (direction) (nearest town)

WELL PURPOSE: Home
(home, irrigation, municipal, industrial)

WELL COMPLETION DATA:

- (1) diameter (inches) 2"
(2) total depth (feet) 480
(3) static water level (feet) 26 below top of ground.
(4) casing PVC (material) (depth) (size) If telescope see back.
(5) screen 10 (length) (depth to top) (size) (material)
(6) pump 1 (HP) 10 (yield gpm) Blue (type power)
(7) electric log NO (yes or no)

(organization running log)

(8) how well bottom plugged Well
Vetna

description of formations encountered

from to

Clay

0 26

sand + gravel

26 108

Clay

108 215

sand

215 236

shale + sand

236 456

sand

456 485

RECEIVED


AUG 21 1976

DRILLERS REMARKS:

MISS. BD. OF WATER COMMISSIONERS

If well telescopes please sketch and show depths.

GROUND LEVEL

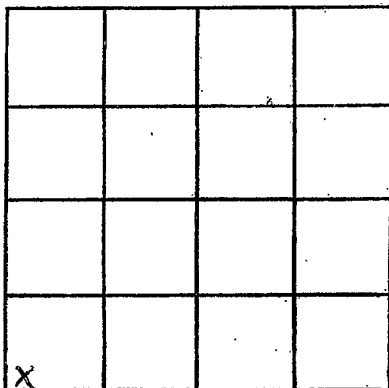

SECTION 18

Please indicate well location X.

ADDITIONAL INFORMATION

If more than one screen, show locations of each on sketch.