

Wash.  
L 2003  
11-2-79

MISSISSIPPI  
BOARD OF WATER COMMISSIONERS  
416 North State Street  
Jackson, Mississippi 39201

WATER WELL DRILLERS LOG

2 Nov 1979 Lambert Drilling Co. Wash  
date well completed firm name county well located

LANDOWNER:	description of formations encountered	from	to
Norman Herring Greenville, Miss. (mailing address)			
WELL LOCATION: sec 17 T 16 N R 7 E 15 miles SE of Green (distance) (direction) (nearest town)	Clay	0	20
WELL PURPOSE: none (home, irrigation, municipal, industrial)	Sand	20	50
WELL COMPLETION DATA: (1) diameter (inches) 4x2 (2) total depth (feet) 450 (3) static water level (feet) 32 below top of ground. (4) casing PVC, 436 (material) (depth) 4x2 (size) if telescope see back. (5) screen 20, 450-436 (length) (depth to top) 2, PVC (size) (material) (6) pump 1 (HP), 20 (yield gpm) elect (type power) (7) electric log (yes or no) (organization running log) (8) how well bottom plugged back frost	Sand, grav.	50	75
	Clay	75	295
	Sand Fine	295	315
	Sand med	315	365
	Sand good	365	450
DRILLERS REMARKS:			

DEPT. OF NATURAL RESOURCES  
BUREAU OF LAND & WATER

JAN 7 1980

RECEIVED


If well telescopes please sketch and show depths.

GROUND LEVEL

4" 140

2" 430

scr. 2" 450

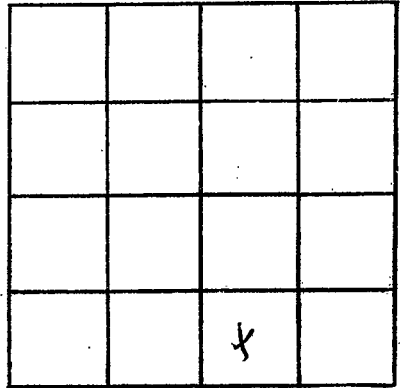

SECTION 17

Please indicate well location X.

ADDITIONAL INFORMATION

If more than one screen, show locations of each on sketch.