

WASHINGTON

L 2004

5-21-79

MISSISSIPPI  
 BOARD OF WATER COMMISSIONERS  
 416 North State Street  
 Jackson, Mississippi 39201

WATER WELL DRILLERS LOG

5-21-79 Scholtz Drilling Co Washington  
 date well completed firm name county well located

LANDOWNER: Aldridge Farms  
Estill, MS.

description of formations encountered

from to

Clay	0	18
SAND	18	30
SAND + gravel	30	60

(mailing address)

WELL LOCATION:

sec 24 T 16 N R 7 E  
 S W  
1 miles West of ESTILL  
 (distance) (direction) (nearest town)

WELL PURPOSE: Farm Use  
 (home, irrigation, municipal, industrial)

WELL COMPLETION DATA:

- (1) diameter (inches) 2"
- (2) total depth (feet) 60'
- (3) static water level (feet) 15' below top of ground.
- (4) casing 2" 55'  
 (material) (depth)  
 (size) If telescope see back.
- (5) screen 5' 55'  
 (length) (depth to top)  
4" BVC  
 (size) (material)
- (6) pump X X  
 (HP) (yield gpm)  
 (type power)
- (7) electric log NO  
 (yes or no)  
 (organization running log)
- (8) how well bottom plugged per Plug

DRILLERS REMARKS:


MISS. Board of Water Comm.

MAY 21 1979

RECEIVED

If well telescopes please sketch and show depths.

GROUND LEVEL

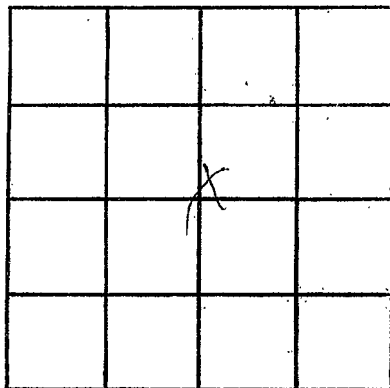

SECTION \_\_\_\_\_

Please indicate well location X.

ADDITIONAL INFORMATION

If more than one screen,  
show locations of each on sketch.