

MISSISSIPPI DEPARTMENT OF NATURAL RESOURCES

Bureau of Land and Water Resources

Southport Mall

P.O. Box 10631

Jackson, Mississippi 39209

WATER WELL DRILLERS LOG

WASH.
L 2005
5-21-81

21 May 1981 date well completed
Coppage Drilling firm name
Washington county well located

LANDOWNER: Anne Stokes
827-7227
Ancola MS
(mailing address)

description of formations encountered	from	to
	Clay	0'
Sand	20'	65'
Gravel	65'	110'
Mud	110'	310'
Sand	310'	440'


WELL LOCATION:
? sec 38 T 16 N R 7 E
5 miles MW of Ancola
(distance) (direction) (nearest town)

WELL PURPOSE: Home
(home, irrigation, municipal, industrial)

- WELL COMPLETION DATA:
- (1) diameter (inches) 4" - 2"
 - (2) total depth (feet) 440'
 - (3) static water level (feet) 28' below above top of ground.
 - (4) casing Sch 40, 405', PVC
(material) (depth)
4" - 2" if telescope see back.
(size)
 - (5) screen 15', 405'
(length) (depth to top)
2" #10 slot PVC
(size) (material)
 - (6) pump 3/4 15
(HP) (yield gpm)

(type power)
 - (7) electric log n/a
(yes or no)


(organization running log)
 - (8) how well bottom plugged Brass Back Wash Valve

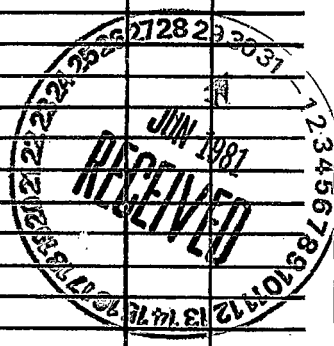

DRILLERS REMARKS:

If well telescopes please sketch and show depths.

GROUND LEVEL

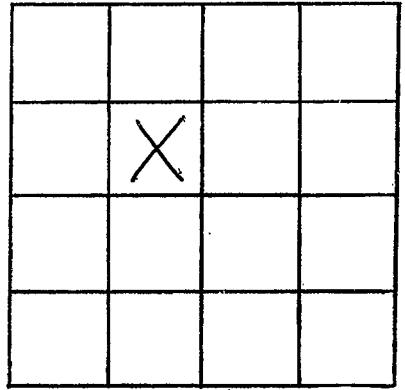

SECTION 16

Please indicate well location X.

ADDITIONAL INFORMATION

160' 4" Sch 40 PVC
245' 2" " " "

If more than one screen, show locations of each on sketch.