

MISSISSIPPI DEPARTMENT OF NATURAL RESOURCES

Bureau of Land and Water Resources

Southport Mall

P.O. Box 10631

Jackson, Mississippi 39209

WATER WELL DRILLERS LOG

WASHINGTON  
L2008

10-13  
date well completed

1985 Schultz Drilling Co.  
firm name

WASHINGTON  
county well located

LANDOWNER:  
MRS E. Richardson  
Wayside, MS  
(mailing address)

description of formations encountered	from	to
CLAY	0	40
SAND	40	70
CLAY	70	180
SHALE	180	290
BROWN CLAY	290	320
SHALE	320	370
SAND -	370	420

WELL LOCATION:  
sec. 18 T. 16 N. R. 7 E. S. 8  
8 miles S of Greenville  
(distance) (direction) (nearest town)

WELL PURPOSE: HOME  
(home, irrigation, municipal, industrial)

- WELL COMPLETION DATA:
- (1) diameter (inches) 2"
  - (2) total depth (feet) 420
  - (3) static water level (feet) 31' below top of ground.
  - (4) casing PVC 410' (material), (depth)
  - (size) if telescope see back.
  - (5) screen 10' 40' (length), (depth to top)
  - 2" PVC (size), (material)
  - (6) pump 1" 10 (HP), (yield gpm)
  - ele (type power)
  - (7) electric log X (yes or no)
  - (organization running log)
  - (8) how well bottom plugged d/w


RECEIVED  
DEC 3 1985

DRILLERS REMARKS:

Department of Natural Resources  
Bureau of Land & Water Resources

If well telescopes please sketch and show depths.

GROUND LEVEL

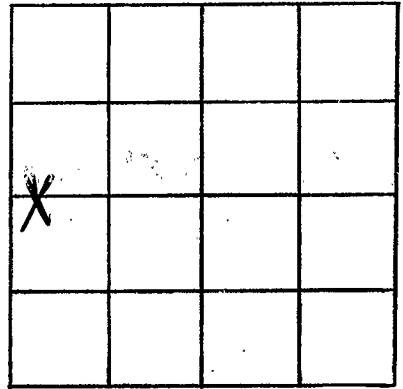

SECTION 8

Please indicate well location X.

ADDITIONAL INFORMATION

If more than one screen,  
show locations of each on sketch.