

WASHINGTON  
L 2009

MISSISSIPPI DEPARTMENT OF NATURAL RESOURCES

Bureau of Land and Water Resources

Southport Mall

P.O. Box 10631

Jackson, Mississippi 39209

WATER WELL DRILLERS LOG

6-27 1986 Schultz Drilling Washington  
date well completed firm name county well located


LANDOWNER: SARA Holmes  
Rt. 2.  
Hollandale MS  
(mailing address)

description of formations encountered	from	to
CLAY	0	18
COARSE SAND	18	145
SHELL SAND	145	340
SAND	340	400

WELL LOCATION:  
sec. 27 T. 16 N R. 7 E  
S NW of Hollandale  
5 miles (distance) (direction) (nearest town)

WELL PURPOSE: HOME  
(home, irrigation, municipal, industrial)

- WELL COMPLETION DATA:
- (1) diameter (inches) 2"
  - (2) total depth (feet) 400'
  - (3) static water level (feet) 21' below top of ground.
  - (4) casing PVC 390' (material) (depth)
  - (size) if telescope see back.
  - (5) screen 10' 390' (length) (depth to top)  
2" PVC (size) (material)
  - (6) pump 1 (HP) 10 (yield gpm)  
ele (type power)
  - (7) electric log no (yes or no)  
(organization running log) X
  - (8) how well bottom plugged b/w

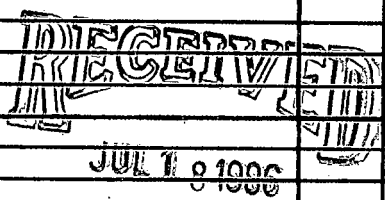


Department of Natural Resources  
Bureau of Land & Water Resources

DRILLERS REMARKS:

If well telescopes please sketch and show depths.

GROUND LEVEL

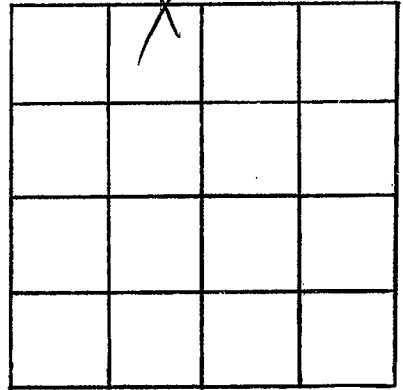

SECTION 29

Please indicate well location X.

ADDITIONAL INFORMATION

If more than one screen, show locations of each on sketch.