

MISSISSIPPI DEPARTMENT OF NATURAL RESOURCES

Bureau of Land and Water Resources

Southport Mall

P.O. Box 10631

Jackson, Mississippi 39209

WATER WELL DRILLERS LOG

WASHINGTON
L 2010

7-15 1986 Schultz Drilling WASHINGTON
date well completed firm name county well located

LANDOWNER: HANK Bordine
Rt. 2
Hollandale, MS
(mailing address)

description of formations encountered	from	to
CLAY	0	30
COARSE SAND + pebbles	30	150
SHALE	150	290
SAND	290	375

WELL LOCATION:
sec. 5 T. 16 N R. 7 E
3 miles W of Hollandale
(distance) (direction) (nearest town)

WELL PURPOSE: Home
(home, irrigation, municipal, industrial)

WELL COMPLETION DATA:

(1) diameter (inches) 4x2"

(2) total depth (feet) 375'

(3) static water level (feet) 21' below top of ground.

(4) casing PVC 3x55'
(material) (depth)

(size) if telescope see back.

(5) screen 20' 3x55'
(length) (depth to top)

2" PVC
(size) (material)


(6) pump 1/2 25
(HP) (yield gpm)

oil
(type power)

(7) electric log no
(yes or no)

(organization running log)

(8) how well bottom plugged b/w

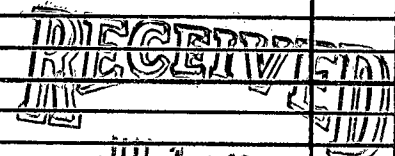

JUL 18 1986

De
Department of Natural Resources
Bureau of Land & Water Resources

DRILLERS REMARKS:

