

WASHINGTON
L 2011

MISSISSIPPI DEPARTMENT OF NATURAL RESOURCES
Bureau of Land and Water Resources
Southport Mall
P.O. Box 10631
Jackson, Mississippi 39209
WATER WELL DRILLERS LOG

8-21 1986 Schultz Drilling Washington
date well completed firm name county well located

LANDOWNER:
CROWE GIN CO.
Estill MS
(mailing address)

description of formations encountered	from	to
CLAY	0	15
SAND	15	75
SAND + GRAVEL	75	165
CLAY	165	260
SHALE	260	390
SAND	390	450

WELL LOCATION:
sec. 24 T. 16 S. R. 7 E.
2 miles N of Hollandale
(distance) (direction) (nearest town)

WELL PURPOSE: Home
(home, irrigation, municipal, industrial)



- WELL COMPLETION DATA:
- (1) diameter (inches) 4" X 2"
 - (2) total depth (feet) 450
 - (3) static water level (feet) 31' below above top of ground.
 - (4) casing PVC 430'
(material) (depth)
2" (size) if telescope see back.
 - (5) screen 20' 430'
(length) (depth to top)
2" PVC
(size) (material)
 - (6) pump 1 1/2 35
(HP) (yield gpm)
elc
(type power)
 - (7) electric log no
(yes or no)
K
(organization running log)
 - (8) how well bottom plugged h/w

RECEIVED
OCT 01 1986

Department of Natural Resources
Bureau of Land & Water Resources

DRILLERS REMARKS:

If well telescopes please sketch and show depths.

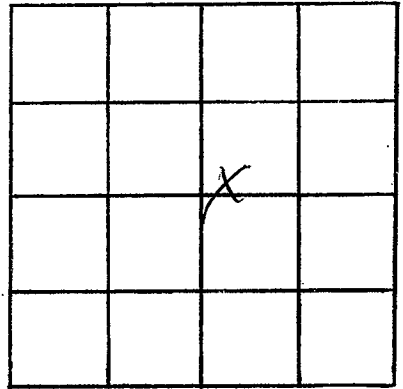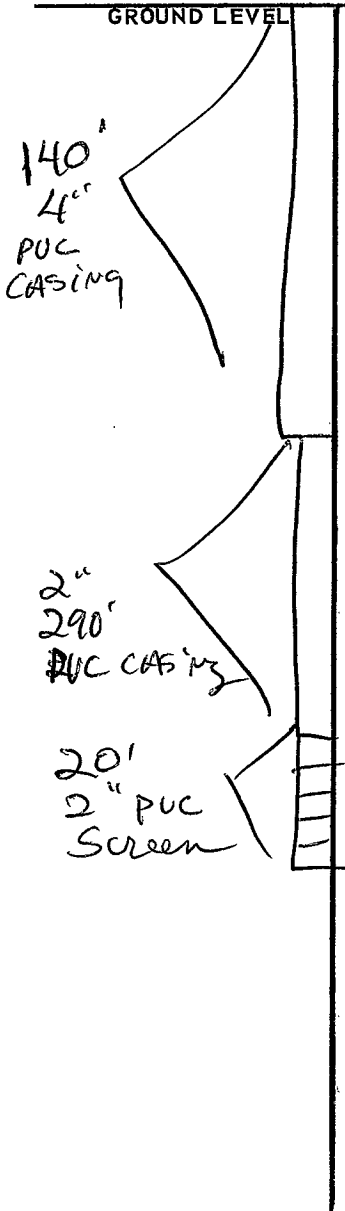

SECTION 24

Please indicate well location X.

ADDITIONAL INFORMATION

Lined area for additional information.

If more than one screen, show locations of each on sketch.