

WASHINGTON  
L 2013

MISSISSIPPI DEPARTMENT OF NATURAL RESOURCES  
Bureau of Land and Water Resources  
Southport Mall  
P.O. Box 10631  
Jackson, Mississippi 39209  
WATER WELL DRILLERS LOG

7-13 1987 date well completed  
Schultz Drilling firm name  
Washington county well located

LANDOWNER: Rutus Williams  
County Rd. 130  
Brewville, Mo. 38701  
(mailing address)

| description of formations encountered | from | to |
|---------------------------------------|------|----|
| CLAY                                  | 0    | 30 |
| SAND                                  | 30   | 75 |

WELL LOCATION:  
sec. 7 T. 16 N. R. 17 E  
4 miles W of Acola  
(distance) (direction) (nearest town)

WELL PURPOSE: None  
(home, irrigation, municipal, industrial)

WELL COMPLETION DATA:

- (1) diameter (inches) 2"
- (2) total depth (feet) 75'
- (3) static water level (feet) 30' below above top of ground.
- (4) casing PVC 65'  
(material) (depth)
- \_\_\_\_\_ if telescope see back.  
(size)
- (5) screen 16' 65'  
(length) (depth to top)
- 2" PVC  
(size) (material)
- (6) pump 1 10  
(HP) (yield gpm)
- ela  
(type power)
- (7) electric log NO  
(yes or no)
- X  
(organization running log)
- (8) how well bottom plugged CAP


DRILLERS REMARKS:

RECEIVED  
OCT 05 1987

Department of Natural Resources  
Bureau of Land & Water Resources

If well telescopes please sketch and show depths.

GROUND LEVEL

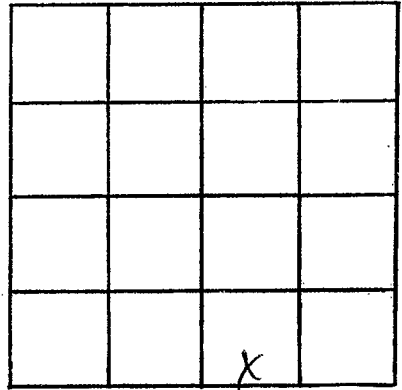

SECTION 7

Please indicate well location X.

ADDITIONAL INFORMATION

If more than one screen,  
show locations of each on sketch.