

MISSISSIPPI DEPARTMENT OF NATURAL RESOURCES

Bureau of Land and Water Resources

Southport Mall

P.O. Box 10631

Jackson, Mississippi 39209

WATER WELL DRILLERS LOG

WASHINGTON
L 2014

24 May 1987 Lambert Drilling Washington
date well completed firm name county well located

LANDOWNER:	description of formations encountered	from	to
<u>Sam Goodman</u>			
<u>Estelle, Miss.</u> (mailing address)	<u>Mixed</u>	<u>0</u>	<u>25</u>
WELL LOCATION: sec <u>24</u> T <u>14</u> N R <u>7</u> E S W	<u>Sand & gravel</u>	<u>25</u>	<u>205</u>
<u>0</u> miles of <u>Estelle</u> (distance) (direction) (nearest town)	<u>Clay</u>	<u>205</u>	<u>365</u>
WELL PURPOSE: <u>home</u> (home, irrigation, municipal, industrial)	<u>Sand</u>	<u>365</u>	<u>440</u>
WELL COMPLETION DATA:			
(1) diameter (inches) <u>4 1/2</u>			
(2) total depth (feet) <u>340</u>			
(3) static water level (feet) <u>46</u> below above top of ground.			
(4) casing <u>PVC</u> , <u>310</u> (material) (depth)			
<u>4 1/2</u> if telescope see back. (size)			
(5) screen <u>30</u> , <u>340-310</u> (length) (depth to top)			
<u>2"</u> , <u>PVC</u> (size) (material)			
(6) pump <u>1</u> , <u>20</u> (HP) (yield gpm)			
<u>elect</u> (type power)			
(7) electric log _____ (yes or no)			
_____ (organization running log)			
(8) how well bottom plugged <u>back proc</u>			
DRILLERS REMARKS:			

RECEIVED

OCT 29 1987

Department of Natural Resources
Bureau of Land & Water Resources


If well telescopes please sketch and show depths.

GROUND LEVEL

180 4"

310 2"

340 2" $\frac{1}{5}$ "

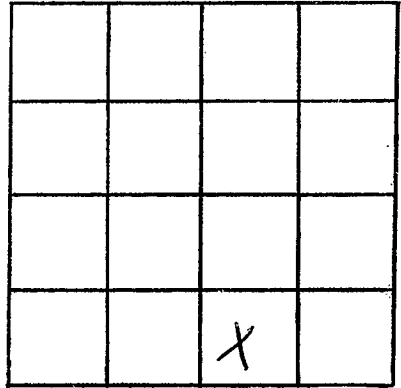

SECTION 2A

Please indicate well location X.

ADDITIONAL INFORMATION

If more than one screen, show locations of each on sketch.