

MISSISSIPPI DEPARTMENT OF NATURAL RESOURCES

Bureau of Land and Water Resources

Southport Mall

P.O. Box 10631

Jackson, Mississippi 39209

WATER WELL DRILLERS LOG

WASHINGTON  
L 2016

2 Oct 1987 date well completed  
Kambert Drilling firm name  
Wash county well located

LANDOWNER:	description of formations encountered	from	to
Debbie McGee Ancola Rd. Greenville, Miss. (mailing address)			
WELL LOCATION:	Sand	19	75
sec. 21 T. 16N S R. 7 E W 14 miles SE of Greenville (distance) (direction) (nearest town)	few gravel	75	95
WELL PURPOSE: None (home, irrigation, municipal, industrial)	Clay	95	480
WELL COMPLETION DATA:	Sand, med	480	495
(1) diameter (inches) 4 1/2	Sand	495	520
(2) total depth (feet) 540			
(3) static water level (feet) 51 below top of ground.			
(4) casing PVC, 510 (material), (depth) 4 1/2 (size) if telescope see back.			
(5) screen 30, 540-570 (length), (depth to top) 24, PVC (size), (material)			
(6) pump 1, 20 (HP), (yield gpm) elect (type power)			
(7) electric log (yes or no) (organization running log)			
(8) how well bottom plugged back cross			

RECEIVED  
RECEIVED

JAN 15 1988

Department of Natural Resources  
Bureau of Land & Water Resources

DRILLERS REMARKS:


If well telescopes please sketch and show depths.

GROUND LEVEL

140 4"

510 2 1/2"

540 2" sc.

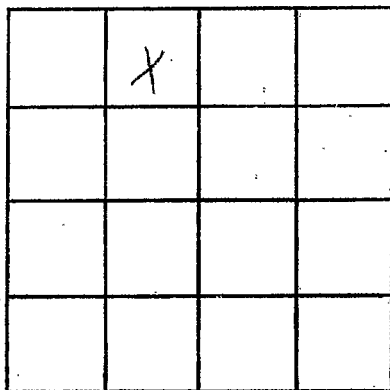

SECTION 31

Please indicate well location X.

ADDITIONAL INFORMATION

If more than one screen, show locations of each on sketch.