

**MISSISSIPPI DEPARTMENT OF ENVIRONMENTAL QUALITY**  
Bureau of Land and Water Resources

P. O. Box 10631  
Jackson, MS 39289-0631  
**WATER WELL DRILLERS LOG**

COUNTY WELL LOCATED <u>Washington</u>	
WELL NUMBER <u>L</u>	CODED
DATE WELL COMPLETED <u>2002</u> <u>5-29-91</u>	

PERMIT NUMBER <u>166A</u> <u>13526</u>
NAME OF DRILLING FIRM <u>Schultz Drilling</u>

NAME & MAILING ADDRESS OF LANDOWNER <u>Hank Burdine</u>			
<u>P.O. Box 596</u>			
<u>Greenville MS, 38701</u>			
WELL LOCATION:	SEC	TOWNSHIP	RANGE
	<u>32</u>	<u>16</u> <u>N</u>	<u>4</u> <u>W</u>
DISTANCE	DIRECTION	NEAREST TOWN	
<u>5</u> Miles	<u>W</u>	of <u>Hollandale</u>	
OTHER LANDMARK			
WELL PURPOSE: Home <u>Irrigation</u> , Municipal, Industrial, Fish Pond, etc.			

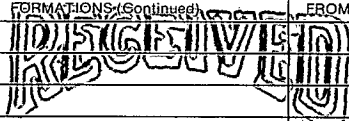
<b>PUMP DATA</b>		
PUMP TYPE (Circle One): Submersible, <u>Turbine</u> Jet Flowing Well, Other (Describe) _____		
POWER TYPE (Circle One): Electric, Tractor, Diesel, Gasoline, <u>Butane</u> , Other (Describe) _____ H/P <u>40</u>		
Pump Capacity (GPM) <u>2000</u>	No. of Stages <u>2</u>	Setting Depth <u>60</u> FT.
PUMP TEST		
Well yielded _____ GPM with a drawdown of _____ ft. after _____ hours of pumping		

<b>WELL DATA</b>		
Well Depth <u>103</u>	Casing Diameter (in.) <u>16</u>	Casing Length (Ft.) <u>63</u>
Type of Casing <u>PVC</u>	Hole Depth <u>103</u>	Depth to Static Water Level <u>27 ft</u>
TYPE OF COMPLETION: (Circle One or More): <u>Gravel Packed</u> , Underreamed, Telescoped, Natural Development, Open Hole, Other (Describe) <u>Hole plug</u>		
Top of Lap Pipe or Reduction in Casing		
FEET		
IF TELESCOPED OR MORE THAN ONE SCREEN: USE BACK PAGE		

<b>LOG DATA</b>	
TYPE OF LOG RUN (Circle One): <u>No Log Run</u> Electric, Gamma Ray, Density, Sonic, Neutron, Other (Describe) _____	
Name of Organization Running Log	

<b>SCREEN DATA</b>		
Diameter - Inches <u>16</u>	Length - Feet <u>40</u>	Slot Size - Inches <u>.050</u>
Screen Type <u>PVC</u>	Depth to Bottom - Feet <u>103</u>	

<b>GEOLOGIC DATA (Office Use Only)</b>			
Surface Elev.	Geologic Unit	Unit Thickness	Depth to Top
Subs. SWL	Date	Analysis	Aquifer Test
Driller's Remarks			

DESCRIPTION OF FORMATIONS ENCOUNTERED	FROM	TO	FORMATIONS (Continued)	FROM	TO
<u>clay</u>	<u>0</u>	<u>23</u>			
<u>sand</u>	<u>23</u>	<u>65</u>			
<u>sand + gravel</u>	<u>65</u>	<u>103</u>			
			<b>DEC 06 1991</b>		
			Dept. of Environmental Quality Bureau of Land & Water Resources		
			IF MORE SPACE IS NEEDED, USE BACK		

If well telescopes please sketch and show depths.

GROUND LEVEL

X			

SECTION W 2

Please indicate well location X.

ADDITIONAL INFORMATION

If more than one screen,  
show location of each on sketch.