

MISSISSIPPI DEPARTMENT OF ENVIRONMENTAL QUALITY

Office of Land and Water Resources

P. O. Box 10631
Jackson, MS 39289-0631
WATER WELL DRILLERS LOG

COUNTY WELL LOCATED
Washington

WELL NUMBER L CODED J

DATE WELL COMPLETED
2032
4-17-95

PERMIT NUMBER _____

NAME OF DRILLING FIRM
Schudco, Ltd.

NAME & MAILING ADDRESS OF LANDOWNER
Jerry McKenzie
5025 Wayneland Dr.
Jackson, MS

WELL LOCATION: SEC 1 TOWNSHIP 16 RANGE 7
N S E W

DISTANCE 1 Miles DIRECTION S NEAREST TOWN Arcaha

OTHER LANDMARK _____

WELL PURPOSE: Home Irrigation, Municipal, Industrial, Fish Pond, etc.

PUMP DATA

PUMP TYPE (Circle One):
Submersible, Turbine, Jet, Flowing Well,
Other (Describe) _____

POWER TYPE (Circle One):
Electric, Tractor, Diesl, Gasoline, Butane,
Other (Describe) _____ H/P 50

Pump Capacity (GPM)	No. of Stages	Setting Depth
<u>2500</u>	<u>1</u>	<u>60</u> FT.

PUMP TEST

Well yielded _____ GPM with
a drawdown of _____ ft.
after _____ hours of pumping

WELL DATA

Well Depth <u>120'</u>	Casing Diameter (In.) <u>16"</u>	Casing Length (Fl.) <u>80'</u>
Type of Casing <u>PVC</u>	Hole Depth <u>120'</u>	Depth to Static Water Level <u>26'</u>

TYPE OF COMPLETION: (Circle One or More):
Gravel Packed, Underreamed, Telescoped,
Natural Development, Open Hole, Other

WELL GROUTED TO A DEPTH OF 10 FEET
Type Grout (circle one): Cement, Bentonite, or Mix

LOG DATA

TYPE OF LOG RUN (Circle One):
Electric, Gamma Ray, Density, Sonic, No Log Run, Neutron,
Other (Describe) _____

Name of Organization Running Log _____

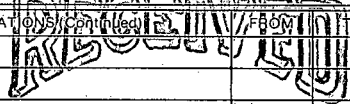
SCREEN DATA

Diameter - Inches <u>16"</u>	Length - Feet <u>40'</u>	Slot Size - Inches <u>.032</u>
Screen Type <u>PVC</u>	Depth to Bottom - Feet <u>120'</u>	

GEOLOGIC DATA (Office Use Only)

Surface Elev.	Geologic Unit	Unit Thickness	Depth to Top
Subs. SWL	Date	Analysis	Aquifer Test

Driller's Remarks _____

DESCRIPTION OF FORMATIONS ENCOUNTERED	FROM	TO	FORMATIONS (Continued) FROM _____ TO _____
<u>Topsoil</u>	<u>0</u>	<u>25</u>	 <u>JAN 22 1996</u> Dept. of Environmental Quality Office of Land & Water Resources
<u>Sand + gravel</u>	<u>25</u>	<u>120</u>	

IF MORE SPACE IS NEEDED, USE BACK

If well telescopes please sketch and show depths.

GROUND LEVEL

X			

SECTION 1

Please indicate well location X.

ADDITIONAL INFORMATION

If more than one screen,
show location of each on sketch.