

MISSISSIPPI DEPARTMENT OF ENVIRONMENTAL QUALITY

Office of Land and Water Resources

P. O. Box 10631
Jackson, MS 39289-0631
WATER WELL DRILLERS LOG

COUNTY WELL LOCATED <u>Washington</u>	
WELL NUMBER <u>L 2030</u>	CODED
DATE WELL COMPLETED <u>3-8-97</u>	

PERMIT NUMBER
NAME OF DRILLING FIRM <u>Schudio Ltd</u>

NAME & MAILING ADDRESS OF LANDOWNER <u>Ballard Farms</u>		
<u>Rt. 1, Box 19</u>		
<u>LELAND MS 38756</u>		
WELL LOCATION: SEC	TOWNSHIP	RANGE
<u>9</u>	<u>16</u> ^N _S	<u>7</u> ^E _W
DISTANCE	DIRECTION	NEAREST TOWN
<u>2 1/2</u> Miles	<u>SW</u>	of <u>Arcola</u>
OTHER LANDMARK		
WELL PURPOSE: Home, Irrigation, Municipal, Industrial, <u>Fish Pond</u> , etc.		

PUMP DATA		
PUMP TYPE (Circle One): Submersible, <u>Turbine</u> , Jet, Flowing Well, Other (Describe) _____		
POWER TYPE (Circle One): <u>Electric</u> , Tractor, Diesel, Gasoline, Butane, Other (Describe) _____ H/P _____		
Pump Capacity (GPM)	No. of Stages	Setting Depth FT.
PUMP TEST		
Well yielded _____ GPM with a drawdown of _____ ft. after _____ hours of pumping		

WELL DATA		
Well Depth <u>100</u>	Casing Diameter (In.) <u>16</u>	Casing Length (Ft.) <u>60</u>
Type of Casing <u>pvc</u>	Hole Depth <u>100</u>	Depth to Static Water Level <u>21 ft</u>
TYPE OF COMPLETION: (Circle One or More): <u>Gravel Packed</u> , Underreamed, Telescoped, Natural Development, Open Hole, Other (Describe) <u>Replacement</u>		
WELL GROUTED TO A DEPTH OF <u>10</u> FEET Type Grout (circle one): Cement, Bentonite, or <u>Mix</u>		

LOG DATA	
TYPE OF LOG RUN (Circle One): Electric, Gamma Ray, Density, Sonic, <u>No Log Run</u> , Other (Describe) _____	
Name of Organization Running Log	

SCREEN DATA		
Diameter - Inches <u>16</u>	Length - Feet	Slot Size - Inches
Screen Type	Depth to Bottom - Feet	


GEOLOGIC DATA (Office Use Only)			
Surface Elev.	Geologic Unit	Unit Thickness	Depth to Top
Subs. SWL	Date	Analysis	Aquifer Test
Driller's Remarks			

DESCRIPTION OF FORMATIONS ENCOUNTERED	FROM	TO	FORMATIONS (Continued)	FROM	TO
<u>Gumbo</u>	<u>0</u>	<u>21</u>	RECEIVED MAY 09 1997 Dept. of Environmental Quality Office of Land & Water Resources		
<u>fine sand</u>	<u>21</u>	<u>57</u>			
<u>course sand & gravel</u>	<u>57</u>	<u>100</u>			

IF MORE SPACE IS NEEDED, USE BACK

If well telescopes please sketch and show depths.

GROUND LEVEL

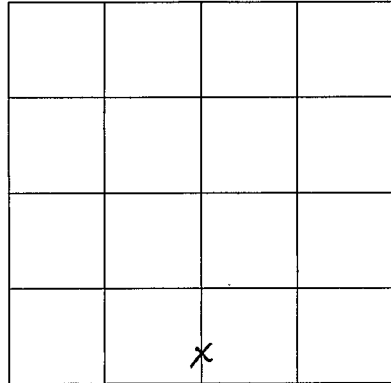

SECTION 9

Please indicate well location X.

ADDITIONAL INFORMATION

If more than one screen,
show location of each on sketch.