

Washington
M
10-2-75

MISSISSIPPI
BOARD OF WATER COMMISSIONERS
416 North State Street
Jackson, Mississippi 39201

WATER WELL DRILLERS LOG


154
date well completed Oct 2, 1975 firm name Owens & Co county well located Wash

LANDOWNER:	description of formations encountered	from	to
<u>Mrs. E. L. Smith</u>			
<u>Rt. 2 - Box 148 - B</u>			
<u>Hollandale, Miss 38748</u> (mailing address)	<u>top soil</u>	<u>0</u>	<u>22</u>
	<u>sand</u>	<u>22</u>	<u>84</u>
	<u>clay</u>	<u>84</u>	<u>126</u>
	<u>sand & gravel</u>	<u>126</u>	<u>189</u>
	<u>Red clay</u>	<u>189</u>	<u>231</u>
	<u>shunt</u>	<u>231</u>	<u>463</u>
WELL LOCATION:			
sec. <u>8</u> T. <u>16</u> N. <u>5</u> R. <u>5</u> E. <u>W</u>			
<u>12</u> miles <u>N.E.</u> of <u>Hollandale</u>			
(distance) (direction) (nearest town)			
WELL PURPOSE: (home, irrigation, municipal, industrial)			
WELL COMPLETION DATA:			
(1) diameter (inches) <u>2"</u>			
(2) total depth (feet) <u>463'</u>			
(3) static water level (feet) <u>19'</u> below top of ground.			
(4) casing <u>steel</u> , <u>453'</u> (material) (depth)			
(size) If telescope see back.			
(5) screen <u>10'</u> , <u>463'</u> (length) (depth to top)			
<u>2"</u> , <u>steel</u> (size) (material)			
(6) pump <u>1</u> (HP) (yield gpm)			
<u>Elec.</u> (type power)			
(7) electric log <u>NO.</u> (yes or no)			
(organization running log)			
(8) how well bottom plugged			
DRILLERS REMARKS: <u>Done</u>			

INDEXED
MAY 19 1975
MISS. BO. OF WATER COMMISSIONERS

If well telescopes please sketch and show depths.

GROUND LEVEL

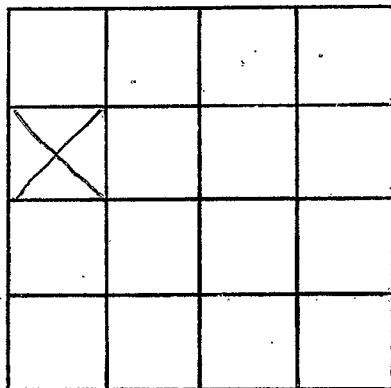

SECTION _____

Please indicate well location X.

ADDITIONAL INFORMATION

If more than one screen, show locations of each on sketch.