

M26

3-22-62

WATER WELL DRILLERS LOG

01262

Date: March 22, 1962, Driller: Layne-Central Company County Washington


(Name)

	Description & Color of Materials Sand, Clay, Red Clay, Shell, etc.	Thick- ness Feet	Depth Feet
(1) Owner of Land: <u>Harris & Wilson</u> (Name) <u>Hollandale, Mississippi</u> (Address)	Clay	14	14
(2) Location: <u>1/4, 1/4, Sec. 25 T16N R5W</u> <i>No sec 2, 3, 4, 26, 27, 28, 99, 100</i> <u>5 1/2</u> miles <u>east</u> of <u>Hollandale</u> (distance) (direction) (Nearest Town)	Brown sand	28	42
(3) Topography: <u>flat</u> (Hilly) (Flat) (Level)	Coarse sand	10	52
(4) Purpose of Well: <u>irrigation</u> (Domestic Irrigation Municipal, Industrial, Other)	Coarse sand & pea gravel	20	72
	Coarse sand, gravel	20	92
	Coarse sand	6	98
	Coarse sand, big gravel	6	104

Information upon completion of well:

- (1) Diameter 12 inches.
- (2) Total Depth 104' - 10" feet.
- (3) Water level 15' feet below top of ground.
- (4) Cased to 5h' - 10", Size 12"
- (5) Screen: Size 12", Length 50'
- (6) Were any formations sealed against pollution?
no yes, no no.

If YES depth of formation _____
Why _____
Drillers Remarks: _____

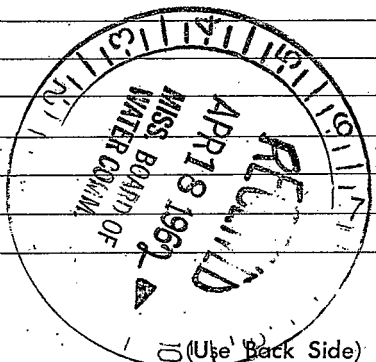

Well No.

