

M28

C1883

1-16-65

WATER WELL DRILLERS LOG

Date: Jan. 16, 1965, Driller: Layne-Central Company County Washington

(Name)

(1) Owner of Land: Dr. L. H. Brandon, Jr. (Name)

Arcola, Mississippi (Address)

(2) Location: 1/4, 1/4, Sec. 7 T16N64 R7W

2 miles southeast of Arcola (distance) (direction) (Nearest Town)

(3) Topography: flat (Hilly) (Flat) (Level)

(4) Purpose of Well: irrigation (Domestic Irrigation) (Municipal, Industrial, Other)

Description & Color of Materials Sand, Clay, Red Clay, Shell, etc.	Thick- ness Feet	Depth Feet
Sandy clay	0	6
Hard yellow clay	12	20
Fine blue sand	20	40
Coarse sand	15	55
Coarse sand, pea gravel	20	75
Gravel & coarse sand	37	112

Information upon completion of well:

(1) Diameter 12 inches.

(2) Total Depth 112 feet.

(3) Water Level 17 feet below top of ground.

(4) Cased to 72', Size 12"

(5) Screen: Size 12", Length 40'


(6) Were any formations sealed against pollution?

yes, no no.

If YES depth of formation

Why

Drillers Remarks:

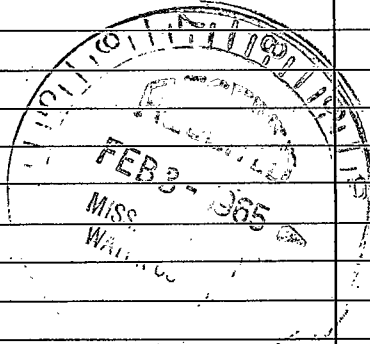

(Use Back Side)

Well No.

