

Washington

M29 MISSISSIPPI BOARD OF WATER COMMISSIONERS

1-67

WATER WELL DRILLERS LOG

Washington

Date: 1-25, 1967, Driller: Migration Serv (Name) County: Leflore

(1) Owner of Land: Sam Jones
(Name)
Hollandale, Miss
(Address)

(2) Location: S.E. 1/4, N.W. 1/4, Sec. 34 T16 R54
10 miles East, of Hollandale
(distance) (direction) (Nearest Town)

(3) Topography: Flat
(Hilly) (Elat) (Level)

(4) Purpose of Well: Migration
(Domestic Irrigation, Municipal, Industrial, Other)

Description & Color of Materials Sand, Clay, Red Clay, Shell, etc.	Thick- ness Feet	Depth Feet
Clay	13	13
Coarse Brown Sand	20	33
Coarse Sand	10	43
Medium Sand	10	53
Coarse Sand	10	63
Coarse Sand & Pea gravel	20	83
- - + Small Rock	20	103
Well Bottomed At	99'	

Well #1

Information upon completion of well:

(1) Diameter 16 inches.

(2) Total Depth 99 feet.

(3) Water Level 17 feet below top of ground.

(4) Cased to 59, Size 16"


(5) Screen: Size 16", Length 40 Ft

(6) Were any formations sealed against pollution?
_____ yes, X no.

If YES depth of formation _____

Why _____

Drillers Remarks: _____

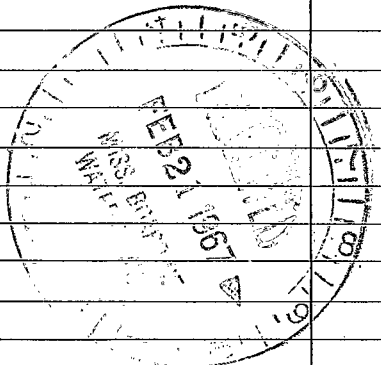

(Use Back Side)

Well No.

