

Washington
M 31
12-67

MISSISSIPPI
BOARD OF WATER COMMISSIONERS
416 North State Street
Jackson, Mississippi 39201

WATER WELL DRILLERS LOG

12/28 1967 Bailey Drilling Co. Washington
date well completed firm name county well located

LANDOWNER: Robt Lundy
Tralake
Miss.
(mailing address)

description of formations encountered	from	to
Clay	0	20
Sand	30	70
Gravel	70	90
Mud	90	280
Sand	280	346


WELL LOCATION:
sec. 1 T. 16 N R. 6 E
1 1/2 miles E of Tralake
(distance) (direction) (nearest town)

WELL PURPOSE: Home
(home, irrigation, municipal, industrial)

WELL COMPLETION DATA:

- (1) diameter (inches) 4 X 2
- (2) total depth (feet) 346
- (3) static water level (feet) 18 below top of ground.
- (4) casing Steel
(material) (depth)
4 X 2 if telescope see back.
(size)
- (5) screen 10' 336
(length) (depth to top)
2" Stainless Steel
(size) (material)
- (6) pump 1/2 10
(HP) (yield gpm)
elec
(type power)
- (7) electric log no
(yes or no)

(organization running log)
- (8) how well bottom plugged
Back pressure valve

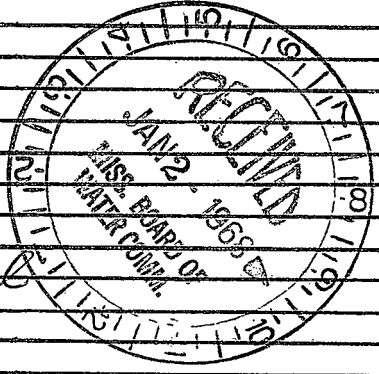

DRILLERS REMARKS:


If well telescopes please sketch and show depths.

GROUND LEVEL

105'

27'

W. 2. Trance

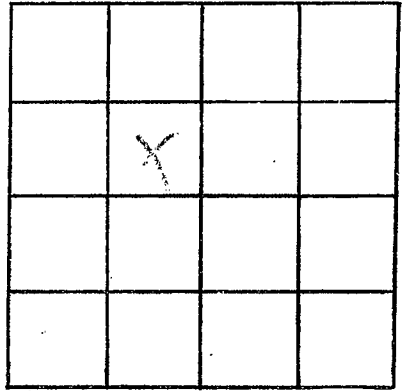

SECTION 1

Please indicate well location X.

ADDITIONAL INFORMATION

If more than one screen, show locations of each on sketch.