

Washington
 M33
 1-68

MISSISSIPPI
 BOARD OF WATER COMMISSIONERS
 416 North State Street
 Jackson, Mississippi 39201
 WATER WELL DRILLERS LOG

8/3/68
 C2579
 Well # 2

January 28, 1968 Layne-Central Company Washington
 date well completed firm name county well located


LANDOWNER: Pooter Brothers, Inc	Description of formations encountered	from	to
Arcola, Mississippi (mailing address)	Clay	000	27
WELL LOCATION: SW 1/4	Fine blue sand	27	35
sec. 5 T. 15 N R. 5 W	Coarse sand	35	114
6 miles east of Arcola	Gravel	114	119
(distance) (direction) (nearest town)	Boulders	119	121
WELL PURPOSE: home	Gravel	121	137
(home, irrigation, municipal, industrial)	Boulders	137	140
WELL COMPLETION DATA:	Clay	140	309
(1) diameter (inches) 4x3	Sandy shale	309	337
(2) total depth (feet) 394	Sand, white coarse	337	389
(3) static water level (feet) 28' below top of ground.	Clay	389	394
(4) casing T&C, 251' of 4" (material) (depth)			
4" 63" if telescope see back. (size) 10" swags.			
(5) screen 30' 8" , 386' 6" (length) (depth to top)			
3" , Stainless steel (size) (material)			
(6) pump 3 (HP) 50 (yield gpm)			
electric (type power)			
(7) electric log no (yes or no)			
(organization running log)			
(8) how well bottom plugged shot			
DRILLERS REMARKS:			

AUG 8 1968

MISS. BD. OF WATER COMMISSIONERS

If well telescopes please
sketch and show depths.

GROUND LEVEL

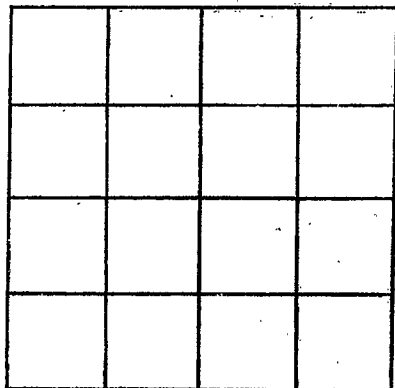

SECTION _____

Please indicate well location X.

ADDITIONAL INFORMATION

If more than one screen,
show locations of each on sketch.