

CODEN

efj/68
C2579
Well #1

MISSISSIPPI
BOARD OF WATER COMMISSIONERS
416 North State Street
Jackson, Mississippi 39201
WATER WELL DRILLERS LOG

Washington
M 3A
1-68

Januayr 18, 19 68 Layne-Central Company Washington
date well completed firm name county well located


LANDOWNER: Potter Brothers, Inc	Description of formations encountered	from	to
	Clay	0	27
	Fine black sand	27	34
Arcola, Mississippi (mailing address)	Coarse sand, coarse gravel	34	120
WELL LOCATION: SW 1/4 sec. 7 T 15 N R 5 E W 16 S W	Pea gravel	120	288
6 miles east of Arcola (distance) (direction) (nearest town)	Pink clay	288	310
	Sandy shale	310	320
	Coarse white sand	320	382
	Clay	382	386
WELL PURPOSE: residence home (home, irrigation, municipal, industrial)			
WELL COMPLETION DATA:			
(1) diameter (inches) 4x3			
(2) total depth (feet) 394			
(3) static water level (feet) 26' below top of ground.			
(4) casing T&C, 118' of 4" casing (material), 238' 6" of 3" (depth)			
4" 83" 10" swage (size) if telescope see back.			
(5) screen 30' 3" , 387' 7" (length) (depth to top)			
3" , stainless steel (size) (material)			
(6) pump 3 50 (HP) (yield gpm)			
electric (type power)			
(7) electric log no (yes or no)			
(organization running log)			
(8) how well bottom plugged shot			
DRILLERS REMARKS:			

AUG 8 1968

MISS. BD. OF
WATER COMM.

If well telescopes please
sketch and show depths.

GROUND LEVEL

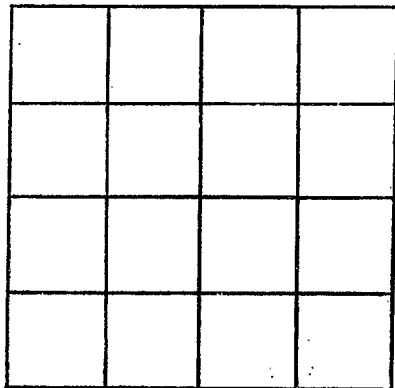

SECTION _____

Please indicate well location X.

ADDITIONAL INFORMATION

If more than one screen,
show locations of each on sketch.