

Dyer Well + Tr. Ser.

CODED

WASHINGTON

M 35

8-29-68

MISSISSIPPI  
BOARD OF WATER COMMISSIONERS  
416 North State Street  
Jackson, Mississippi 39201

WATER WELL DRILLERS LOG

AUG. 29 1968  
date well completed

Hamp Collier Washington  
firm name county well located

LANDOWNER:

Hamp Collier  
Holladay, Miss  
(mailing address)

description of formations encountered

from to

CLAY	0	17
CLAY	13	23
FINE SAND	23	37
FINE SAND & CLAY	33	43
COARSE SAND & GRA	43	53
MED SAND	53	63
FINE SAND	63	73
C. SAND SMALL GRA.	73	83
C. SAND & GRAVEL	83	93
✓ ✓ ✓	93	103
✓ ✓ ✓	103	113

WELL LOCATION:

sec 31 T. 16 N R. 5 E  
5 miles EAST of HOLLADAY  
(distance) (direction) (nearest town)


WELL PURPOSE:

IND. USE  
(home, irrigation, municipal, industrial)

WELL COMPLETION DATA:

- (1) diameter (inches) 16"
- (2) total depth (feet) 113'
- (3) static water level (feet) 28' below top of ground
- (4) casing 16" (material) 73' (depth)
- (5) screen 16" (size) 40' (length) 73' (depth to top)
- (6) pump 50 (HP) 2500 (yield gpm)  
DIESEL (type power)
- (7) electric log NO (yes or no)
- (8) how well bottom plugged PLATE

DRILLERS REMARKS:

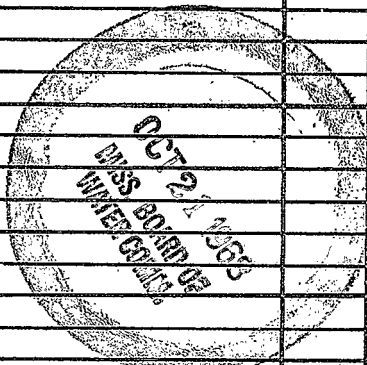

If well telescopes please sketch and show depths.

GROUND LEVEL

		X	

SECTION 31

Please indicate well location X.

ADDITIONAL INFORMATION

If more than one screen, show locations of each on sketch.