

Washington
M 36
5-6-68

MISSISSIPPI
BOARD OF WATER COMMISSIONERS
416 North State Street
Jackson, Mississippi 39201

CODED

WATER WELL DRILLERS LOG

5-6-68 19 J. F. Newton Washington
date well completed firm name county well located

David Benny

LANDOWNER: J. F. Newton

Hollandale, Miss

description of formations encountered	from	to
Clay	0	20
sand	20	127
Clay	127	190
sand with S-Bd.	190	221
shale & sand	221	253
sand	253	284
Dark w/ phos. sh.	284	315
sand	315	409

(mailing address)

WELL LOCATION:

sec. 31 T. 16 N R. 6 E
5 W
2 miles NE of Hollandale
(distance) (direction) (nearest town)

WELL PURPOSE:
(home, irrigation, municipal, industrial)

WELL COMPLETION DATA:

- (1) diameter (inches) 3 1/2
- (2) total depth (feet) 409
- (3) static water level (feet) _____ below above top of ground.
- (4) casing galv 389
(material) (depth)
3 1/2 if telescope see back.
(size) 105" 2 3/4"
- (5) screen 20 389
(length) (depth to top)
2" 007 Monel
(size) (material)
- (6) pump 1 _____
(HP) (yield gpm)
Elec.
(type power)
- (7) electric log NO
(yes or no)

CODED

1966

MISS. BD. OF
WATER COMMISSIONERS

(organization running log)

(8) how well bottom plugged _____

DRILLERS REMARKS:


If well telescopes please sketch and show depths.

GROUND LEVEL

105'
of 3"

204'
of
2"

20'
of
screen

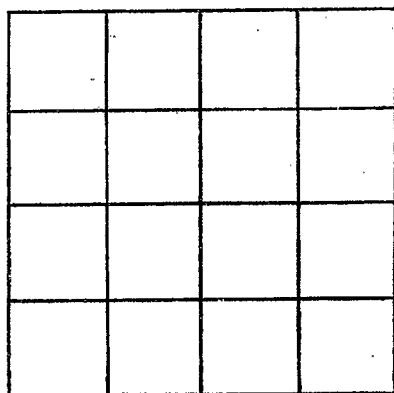

SECTION 31

Please indicate well location X.

ADDITIONAL INFORMATION

If more than one screen, show locations of each on sketch.