

Washington
M37

MISSISSIPPI BOARD OF WATER COMMISSIONERS

CODED

3-66

WATER WELL DRILLERS LOG

Washington

Date: 3-5, 1966, Driller: Butane Gas Co. of Greenwood, Leflore County, Leflore

(Name)

(1) Owner of Land: Albert Prevot
(Name)
Hollandale, Miss.
(Address)

(2) Location: SE 1/4, NW 1/4, Sec. 14 T. 16N R. 6W
5 miles N.E. of Hollandale
(distance) (direction) (Nearest Town)

(3) Topography: Flat
(Hilly) (Flat) (Level)

(4) Purpose of Well: Irrigation
(Domestic Irrigation
Municipal, Industrial, Other)

Description & Color of Materials Sand, Clay, Red Clay, Shell, etc.	Thick- ness Feet	Depth Feet
Clay	13	13
Coarse Sand	10	23
Coarse Sand	10	33
Coarse Sand	10	43
Coarse Sand	10	53
Coarse Sand	10	63
Coarse Sand	10	73
Coarse Sand	10	83
Sand and Gravel	10	93
Sand and Gravel	10	103

CODED

Information upon completion of well:

(1) Diameter 16 inches.

(2) Total Depth 103 feet.

(3) Water Level 22 feet below top of ground.

(4) Cased to 63, Size 16

(5) Screen: Size 16, Length 40


(6) Were any formations sealed against pollution?
yes, X no.

If YES depth of formation

Why

Drillers Remarks:

Insuff. info.
to locate

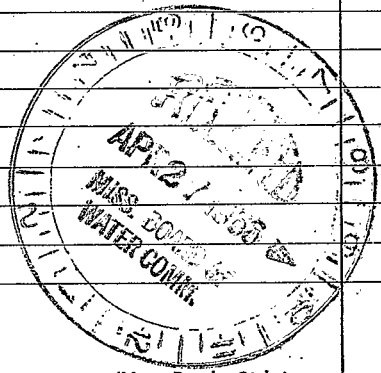

(Use Back Side)

Well No.

