

Washington
M 38

MISSISSIPPI BOARD OF WATER COMMISSIONERS

CODED

2-66

WATER WELL DRILLERS LOG

Washington
Leflore

Date: 2-12, 19 66, Driller: Butane Gas Co. County: Leflore

(Name)

(1) Owner of Land: J. H. Theunissen
(Name)
Hollandale, Miss.
(Address)

(2) Location: NE 1/4, SW 1/4, Sec. 24, T. 16N, R. 6W
6 miles N.E. of Hollandale
(distance) (direction) (Nearest Town)
Flat
(3) Topography: (Hilly) (Flat) (Level)

(4) Purpose of Well: Irrigation
(Domestic, Irrigation, Municipal, Industrial, Other)

| Description & Color of Materials Sand, Clay, Red Clay, Shell, etc. | Thick- ness Feet | Depth Feet |
|---|------------------------|---------------|
| Top soil | 13 | 13 |
| Blue Clay | 10 | 23 |
| Coarse Sand | 10 | 33 |
| Coarse Sand | 10 | 43 |
| Coarse Sand | 10 | 53 |
| Sand and Gravel | 10 | 63 |
| Sand and Gravel | 10 | 73 |
| Sand and Gravel | 10 | 83 |
| Sand and Gravel | 10 | 93 |
| Sand and Gravel | 10 | 103 |
| Sand and Gravel | 10 | 113 |

CODED

Information upon completion of well:

(1) Diameter 16 inches.

(2) Total Depth 112 feet.

(3) Water Level 15 feet below top of ground.

(4) Cased to 72, Size 16

(5) Screen: Size 16, Length 40


(6) Were any formations sealed against pollution?
yes, no.

Insuff. info.
to locate

If YES depth of formation _____

Why _____

Drillers Remarks: _____

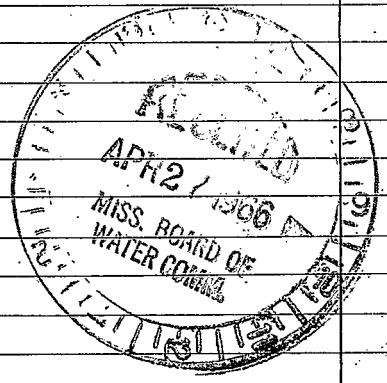

(Use Back Side)

Well No.

1954
1955
1956
1957