

CODED

1/31/69

Washington
M 42
1-23-69

MISSISSIPPI  
 BOARD OF WATER COMMISSIONERS  
 416 North State Street  
 Jackson, Mississippi 39201

CODED  
 CODED  
 2804

WATER WELL DRILLERS LOG

January 23, 1969 Layne-Central Company Washington  
 date well completed firm name county well located

LANDOWNER: Frey Farms, Inc.	description of formations encountered	from	to
Hollandale, Mississippi (mailing address)			
WELL LOCATION: sec 20 T 16 N R 6 E 2 miles east of Estill (distance) (direction) (nearest town)	Fine sand	3	6
WELL PURPOSE: irrigation (home, irrigation, municipal, industrial)	White clay	6	15
WELL COMPLETION DATA: (1) diameter (inches) 16	Coarse sand, no gravel, just real coarse sand	15	120
(2) total depth (feet) 120			
(3) static water level (feet) 14 below above top of ground.			
(4) casing steel 60' (material), (depth), 16" (size) if telescope see back.			
(5) screen 60' (length), 120' (depth to top), 16" (size), Armco (material)			
(6) pump (HP) 2400 (yield gpm) HP - not available. (type power)			
(7) electric log no (yes or no) (organization running log)			
(8) how well bottom plugged plate			

CODED

CODED

CODED

CODED


FEB - 7 1969

MISSISSIPPI WATER BOARD

DRILLERS REMARKS:  
 Purchaser to furnish and install own pumping equipment.

If well telescopes please sketch and show depths.

GROUND LEVEL

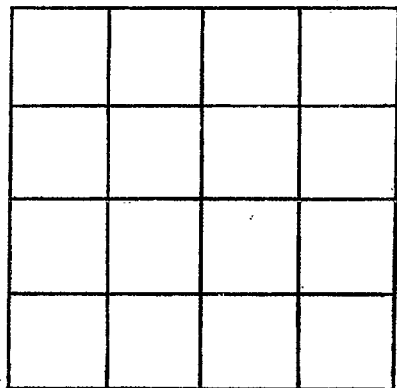

SECTION \_\_\_\_\_

Please indicate well location X.

ADDITIONAL INFORMATION

If more than one screen,  
show locations of each on sketch.