

WASH'N

MISSISSIPPI BOARD OF WATER COMMISSIONERS

Canal 7/9/69 Jm

M 46

7-20-57

WATER WELL DRILLERS

**CODED**

9/27/65

JC 421  
WASHINGTON  
Oklahoma

Date: July 20, 1957, Driller: Layne-Central Company County Oklahoma  
(Name)

(1) Owner of Land: P. F. Williams & Sons  
(Name)

Clarksdale, Mississippi  
(Address)

(2) Location: 1/4, 1/4, Sec. T R

1 miles north of Hollandale  
(distance) (direction) (Nearest Town)

(3) Topography: flat  
(Hilly) (Flat) (Level)

(4) Purpose of Well: irrigation  
(Domestic Irrigation  
Municipal, Industrial, Other)

Information upon completion of well:

- (1) Diameter 12 inches.
- (2) Total Depth 108 feet.
- (3) Water Level 19' 6" feet below top of ground.
- (4) Cased to 58', Size 12"
- (5) Screen: Size 12", Length 50'
- (6) Were any formations sealed against pollution?  
no yes, no no.

If YES depth of formation \_\_\_\_\_

Why \_\_\_\_\_

Drillers Remarks: \_\_\_\_\_


2030 GPM.

Engine drive.

Description & Color of Materials Sand, Clay, Red Clay, Shell, etc.	Thick- ness Feet	Depth Feet
Clay	29	29
Fine sand & clay	10	39
Fine red sand	5	44
Coarse sand	64	108

Insuff. info  
to locate

**CODED**

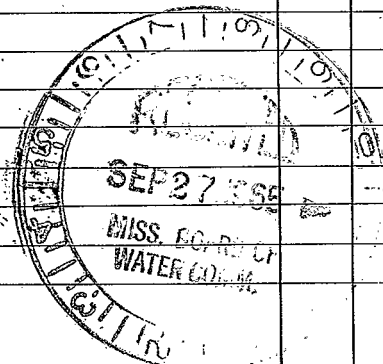

Well No.

(Use Back Side)

