

M 48

6-11-65

WATER WELL DRILLERS LOG

Cons 7/9/69 JN

CODED

20

Date: June 11, 1965, Driller: Layne-Central Company County Washington

(Name)

(1) Owner of Land: L. W. Stephens

(Name)

Arcola, Mississippi

(Address)

(2) Location: 20 16 N 6 W $\frac{1}{4}$, $\frac{1}{4}$, Sec. T R

2 miles east of Estill
(distance) (direction) (Nearest Town)

(3) Topography: flat

(Hilly) (Flat) (Level)

(4) Purpose of Well: irrigation

(Domestic Irrigation
Municipal, Industrial, Other)

| Description & Color of Materials Sand, Clay, Red Clay, Shell, etc. | Thick- ness Feet | Depth Feet |
|---|------------------------|---------------|
| Clay | 20 | 20 |
| Fine sand | 12 | 32 |
| Medium sand | 24 | 56 |
| Coarse sand, pea gravel | 43 | 99 |
| Coarse sand, big gravel | 13 | 112 |

Information upon completion of well:

(1) Diameter 12 inches.

(2) Total Depth 112 feet.

(3) Water Level 17'-2" feet below top of ground.

(4) Cased to 62', Size 12"

(5) Screen: Size 12", Length 50'

(6) Were any formations sealed against pollution?

no yes, no no.

If YES depth of formation _____

Why _____


Drillers Remarks: _____

1500 GPM

engine drive

CODED

*Insuff info
to locate*

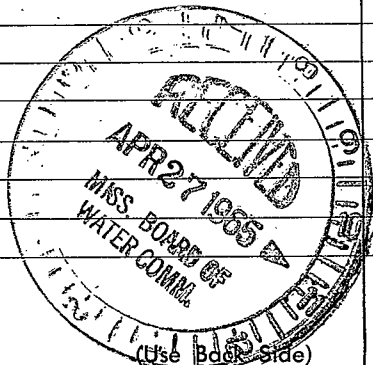

Well No.

100