

Washington
M 49
10-25-71

MISSISSIPPI
BOARD OF WATER COMMISSIONERS
416 North State Street
Jackson, Mississippi 39201

FEB 14 1972

WATER WELL DRILLERS LOG

10-25 date well completed
1971 Schufft Drilling firm name
Washington county well located



LANDOWNER: <u>Mr. Ruma</u>	description of formations encountered	from	to
<u>Hollendale, Miss</u> (mailing address)	Clay	0	15
	Sand	15	147
WELL LOCATION: sec <u>35</u> T <u>16N</u> R <u>6E</u>	Clay	147	182
<u>4</u> miles <u>East</u> of <u>Hollendale</u> (distance) (direction) (nearest town)	Sand	182	190
WELL PURPOSE: <u>Home</u> (home, irrigation, municipal, industrial)	Clay + sand + shale	190	242
WELL COMPLETION DATA:	Sandy shale	242	263
(1) diameter (inches) <u>4x2</u>	Sand	263	365
(2) total depth (feet) <u>483</u>	Shale	365	384
(3) static water level (feet) <u>26</u> ^{below} _{above} top of ground.	Sand	384	486
(4) casing <u>P.V.</u> (material) (depth)			
<u>1/2"</u> (size) If telescope see back.			
(5) screen <u>20</u> (length) (depth to top)			
<u>5"</u> <u>Stainless</u> (size) (material)			
(6) pump <u>1</u> <u>2L</u> (HP) (yield gpm)			
<u>Electric</u> (type power)			
(7) electric log <u>NO</u> (yes or no)			
(organization running log)			
(8) how well bottom plugged <u>Sealed</u>			
DRILLERS REMARKS:			

CODED

CODED

If well telescopes please sketch and show depths.

GROUND LEVEL

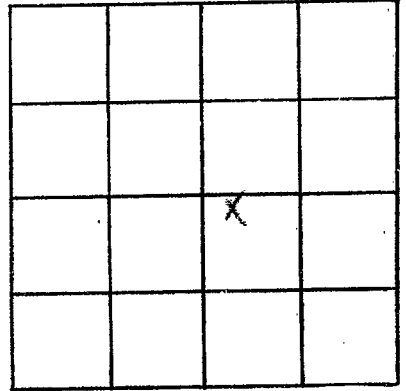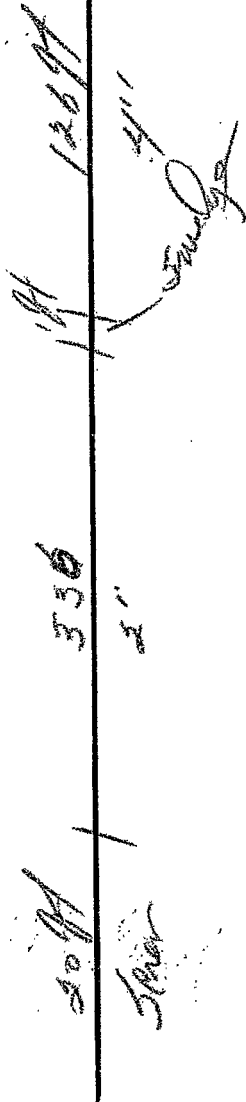

SECTION 35

Please indicate well location X.

ADDITIONAL INFORMATION

Lined area for additional information.

If more than one screen, show locations of each on sketch.