

WASHINGTON
M50
9-11-72

MISSISSIPPI
BOARD OF WATER COMMISSIONERS
416 North State Street
Jackson, Mississippi 39201

WATER WELL DRILLERS LOG

CODED

Sept. 11 1972 Owens Plumbing Wash.
date well completed firm name county well located

LANDOWNER: WILLIAM ROSS
Rt. 2, Box 164A
HOLLANDALE MS. 38748
(mailing address)

description of formations encountered	from	to
top soil	0	20
sand	20	144
sand + gravel	144	270
sand	270	440

WELL LOCATION:
sec. 36 T 16 S R 4 E
10 miles E of HOLLANDALE
(distance) (direction) (nearest town)

WELL PURPOSE: Home
(home, irrigation, municipal, industrial)

- WELL COMPLETION DATA:
- (1) diameter (inches) 2"
 - (2) total depth (feet) 440'
 - (3) static water level (feet) 22 below top of ground.
 - (4) casing P.A.V. 430'
(material) (depth)
(size) if telescope see back.
 - (5) screen 10' 440'
(length) (depth to top)
2" S.S.
(size) (material)
 - (6) pump 1 72 P.A.V.
(HP) (yield gpm)
E/F.C.
(type power)
 - (7) electric log NO
(yes or no)
 - (organization running log)
 - (8) how well bottom plugged S-B

CODED


OCT - 3 1972

DRILLERS REMARKS: OWENS

MISS. Bd. OF
WATER COMMISSIONERS

If well telescopes please sketch and show depths.

GROUND LEVEL

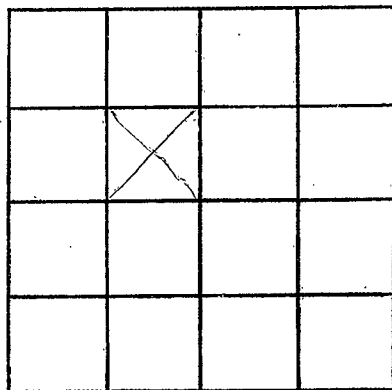

SECTION _____

Please indicate well location X.

ADDITIONAL INFORMATION

If more than one screen, show locations of each on sketch.