

WASHINGTON
M 51
10-16-72

MISSISSIPPI
BOARD OF WATER COMMISSIONERS
416 North State Street
Jackson, Mississippi 39201

CODED

WATER WELL DRILLERS LOG

16 Oct 72 19 Lambert Drilling Wash date well completed firm name county well located

LANDOWNER:
John Stevens,
Arvoda, Miss.
(mailing address)

description of formations encountered	from	to
clay	0	10
sand	10	85

WELL LOCATION:
sec. 17 T. 16 N. R. 6 E
5 miles S/E of Arvoda
(distance) (direction) (nearest town)

WELL PURPOSE: home
(home, irrigation, municipal, industrial)

- WELL COMPLETION DATA:
- (1) diameter (inches) 4"
 - (2) total depth (feet) 78'
 - (3) static water level (feet) 12 below top of ground.
 - (4) casing PVC, 68' (material), (depth)
4x2 (size) if telescope see back.
 - (5) screen 10', 78-68' (length), (depth to top)
2" PVC, (size), (material)
 - (6) pump 1 HP, 19 (yield gpm)
ELECT (type power)
 - (7) electric log (yes or no)
 - (organization running log)
 - (8) how well bottom plugged
check wash valve

CODED

NEW - 3 13/16
100'

DRILLERS REMARKS:

MISS. BD. OF
WATER COMMISSIONERS

If well telescopes please sketch and show depths.


GROUND LEVEL

4

65

2"
Screen

75

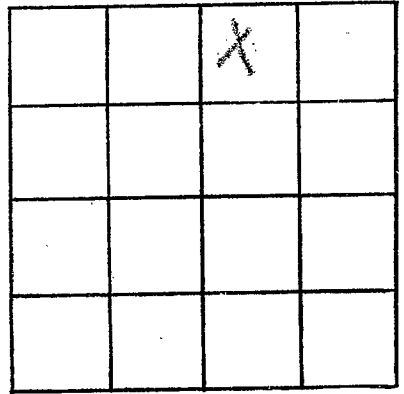

SECTION 17

Please indicate well location X.

ADDITIONAL INFORMATION

If more than one screen, show locations of each on sketch.