

WASH
M 54
7-2-73

MISSISSIPPI
BOARD OF WATER COMMISSIONERS
416 North State Street
Jackson, Mississippi 39201

CODED

WATER WELL DRILLERS LOG

7-2 date well completed 73 OWENS P & WOOD Wash firm name county well located

LANDOWNER: HOUSTON ESTATE
Circle "C" FARM
Rt. 1, Izola, MISS
(mailing address)

description of formations encountered	from	to
top soil	0	20
Clay	20	144
Sand & gravel	144	245
Sound	245	250

WELL LOCATION:
sec. 27 T. 16 N R. 5 E
8 S 4 W
miles of (distance) (direction) (nearest town)

WELL PURPOSE:
(home, irrigation, municipal, industrial)

WELL COMPLETION DATA:

(1) diameter (inches) 2"

(2) total depth (feet) 2480'

(3) static water level (feet) 38' below top of ground.

(4) casing GALV 470' (material) (depth)
110 (size) If telescope see back.

(5) screen 10' 480' (length) (depth to top)
2" (size) SS (material)

(6) pump 1 1/2 60 (HP) (yield gpm)
Elec (type power)

(7) electric log NO (yes or no)

(organization running log)

(8) how well bottom plugged S-B


CODED

DRILLERS REMARKS: OWENS

AUG 3 1973

If well telescopes please sketch and show depths.

GROUND LEVEL

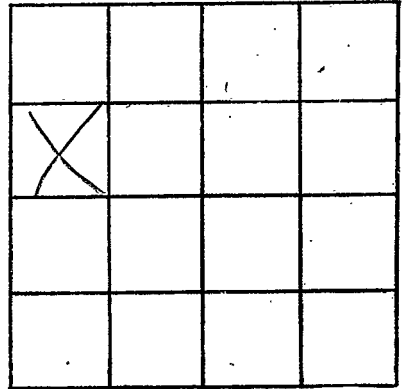

SECTION _____

Please indicate well location X.

ADDITIONAL INFORMATION

If more than one screen, show locations of each on sketch.