

WASH.  
M55  
6-13-73

MISSISSIPPI  
BOARD OF WATER COMMISSIONERS  
416 North State Street  
Jackson, Mississippi 39201

CODED

WATER WELL DRILLERS LOG

6-13 1973 DYEER WELL & IRRIGATION SERVICE WASHINGTON  
date well completed firm name county well located

LANDOWNER: Dave Jones  
ISOLA,  
Miss.  
(mailing address)

description of formations encountered	from	to
<u>Clay</u>	<u>0</u>	<u>25</u>
<u>fine sand</u>	<u>25</u>	<u>40</u>
<u>sand gravel</u>	<u>40</u>	<u>113</u>

WELL LOCATION:  
sec. 34 T 16 N R. 5 E  
8 miles E of HOLLANDALE  
(distance) (direction) (nearest town)

WELL PURPOSE: IRR.  
(home, irrigation, municipal, industrial)

- WELL COMPLETION DATA:
- (1) diameter (inches) 16"
  - (2) total depth (feet) 113'
  - (3) static water level (feet) 19' below top of ground.
  - (4) casing BLK IR, 73'  
(material), (depth)  
16" if telescope see back.  
(size)
  - (5) screen 40', 73'  
(length), (depth to top)  
16", BLK IR  
(size), (material)
  - (6) pump 50 2750  
(HP) (yield gpm)  
Diesel  
(type power)
  - (7) electric log no  
(yes or no)
  - (organization running log)
  - (8) how well bottom plugged PERTE


CODED

DRILLERS REMARKS:

OCT 25 1973

If well telescopes please sketch and show depths.

GROUND LEVEL

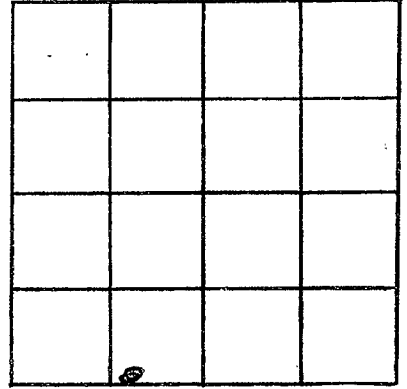

SECTION 34

Please indicate well location X.

ADDITIONAL INFORMATION

If more than one screen,  
show locations of each on sketch.