

217252

WASHINGTON
M56
1-22-74

MISSISSIPPI
BOARD OF WATER COMMISSIONERS
416 North State Street
Jackson, Mississippi 39201
WATER WELL DRILLERS LOG

CODED

January 22, 19 74 Singer-Layne Central Div. Washington
date well completed firm name county well located

LANDOWNER:

Crowe Brothers

Hollandale, Mississippi
(mailing address)

description of formations encountered

from

to

Clay	0	16
Coarse Sand	16	35
Coarse Sand & Pea Gravel	35	80
Coarse Sand Gravel	80	110
Boulders	110	113

WELL LOCATION:

sec. 20 T. 16 N R. 6 W
3 miles East of Estill
(distance) (direction) (nearest town)

WELL PURPOSE: Irrigation
(home, irrigation, municipal, industrial)

WELL COMPLETION DATA:

- (1) diameter (inches) 16"
- (2) total depth (feet) 113'
- (3) static water level (feet) 13' below top of ground.
- (4) casing Steel 53" (material) (depth)
16" (size) if telescope see back.
- (5) screen 60' 113' (length) (depth to top)
16" Steel (size) (material)
- (6) pump 60 2800 (HP) (yield gpm)
Engine (type power)
- (7) electric log No (yes or no)
(organization running log)
- (8) how well bottom plugged Plate

CODED




FEB 7 1974

MISS. BD. OF WATER COMMISSIONERS

DRILLERS REMARKS:

If well telescopes please
sketch and show depths.

GROUND LEVEL

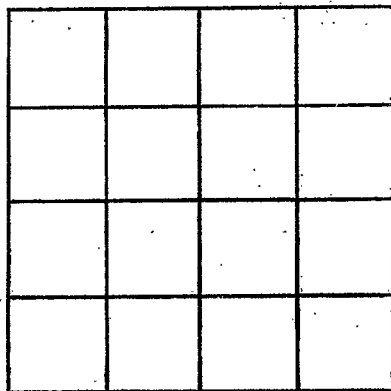

SECTION _____

Please indicate well location X.

ADDITIONAL INFORMATION

If more than one screen,
show locations of each on sketch.