

WASHINGTON
M 59
4-5-74

MISSISSIPPI
BOARD OF WATER COMMISSIONERS
416 North State Street
Jackson, Mississippi 39201

CODED

WATER WELL DRILLERS LOG

April 5, 1974 Singer-Layne Central Div. Washington
date well completed firm name county well located

LANDOWNER:	description of formations encountered	from	to
Kenneth Frey			
Hollandale, Mississippi	Sand	18	42
(mailing address)	Pea Gravel	42	55
WELL LOCATION:	Coarse Sand	55	75
sec. 33 T 16 N R 6 E	Sand Gravel	75	80
4 miles NE of Hollandale	Rock and Sand	80	112
(distance) (direction) (nearest town)			
WELL PURPOSE: Irrigation			
(home, irrigation, municipal, industrial)			
WELL COMPLETION DATA:			
(1) diameter (inches) 16"			
(2) total depth (feet) 108'			
(3) static water level (feet) 12' below top of ground.			
(4) casing Steel 58'			
(material) (depth)			
16" if telescope see back.			
(size)			
(5) screen 50' 108'			
(length) (depth to top)			
16" Armco Iron			
(size) (material)			
(6) pump 50 2500			
(HP) (yield gpm)			
(type power)			
(7) electric log No			
(yes or no)			
(organization running log)			
(8) how well bottom plugged Plate			
DRILLERS REMARKS:			


CODED

APR 24 1974

MISS. RD. OF WATER COMMISSIONERS

If well telescopes please sketch and show depths.

GROUND LEVEL

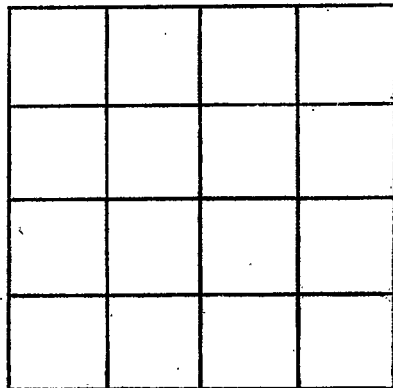

SECTION _____

Please indicate well location X.

ADDITIONAL INFORMATION

If more than one screen, show locations of each on sketch.