

WASH.  
M60  
5-5-74

MISSISSIPPI  
BOARD OF WATER COMMISSIONERS  
416 North State Street  
Jackson, Mississippi 39201

CODED

WATER WELL DRILLERS LOG  
DYER WELL & IRRIGATION SERVICE

WASHINGTON  
county well located

MAY 5, 74 19  
date well completed

firm name

LANDOWNER:  
Tom BURTON  
HOLLANDALE, MISS.  
(mailing address)


description of formations encountered	from	to
CLAY	0	22
SAND & PEA ROCK	22	36
SAND PEA ROCK	36	
LARGE GRAVEL		106

WELL LOCATION:  
sec. 3 T. 16 N R. 6 E S. 2  
2 miles EAST of HOLLANDALE  
(distance) (direction) (nearest town)

WELL PURPOSE: IRR.  
(home, irrigation, municipal, industrial)

- WELL COMPLETION DATA:
- (1) diameter (inches) 12"
  - (2) total depth (feet) 106'
  - (3) static water level (feet) 16' below above top of ground.
  - (4) casing 4" IRON, 66' (material), (depth)  
12" (size) if telescope see back.
  - (5) screen 40', 66' (length), (depth to top)  
12" BUR TUBING (size), (material)
  - (6) pump 30 (HP), 1800 (yield gpm)  
TRACTOR Diesel (type power)
  - (7) electric log No (yes or no)
  - (organization running log)
  - (8) how well bottom plugged PLATE


DRILLERS REMARKS:

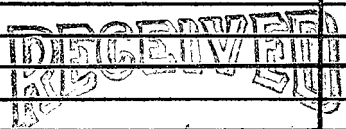

NOV 21 1974

If well telescopes please sketch and show depths.

GROUND LEVEL

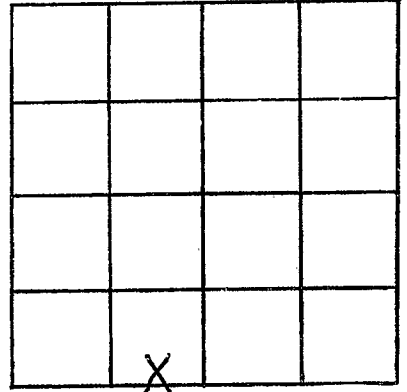

SECTION 3

Please indicate well location X.

ADDITIONAL INFORMATION

If more than one screen,  
show locations of each on sketch.