

WASH.
M 61
12-20-74

MISSISSIPPI
BOARD OF WATER COMMISSIONERS
416 North State Street
Jackson, Mississippi 39201 **CODED**

WATER WELL DRILLERS LOG

20 Dec 1974 Lambert Drilling Co Wash
date well completed firm name county well located

LANDOWNER:
John Stevens
Arcola, Miss.
(mailing address)

WELL LOCATION:
sec 17 T 16 N R 6 E
2 miles S/E of Arcola
(distance) (direction) (nearest town)

WELL PURPOSE: home
(home, irrigation, municipal, industrial)

WELL COMPLETION DATA:
(1) diameter (inches) 4x2
(2) total depth (feet) 400
(3) static water level (feet) 30 below top of ground.
(4) casing Galv. 291 (material) (depth)
4x2 (size) If telescope see back.
(5) screen 20 41-391 (length) (depth to top)
21 S.S. (size) (material)
(6) pump 1 20 (HP) (yield gpm)
elect (type power)
(7) electric log (yes or no)
(organization running log)
(8) how well bottom plugged back wash

description of formations encountered	from	to
Mixed	0	15
Sand	15	80
Sand & gravel	80	105
Clay	105	165
Sand & silt	165	370
St. Clay	165	370
Sand, good	370	420

RECEIVED
FEB 5 - 1975

MISS. RD. OF WATER COMM.

DRILLERS REMARKS:


If well telescopes please sketch and show depths.

GROUND LEVEL

126'
4"

265'
2"

20'
SS screen

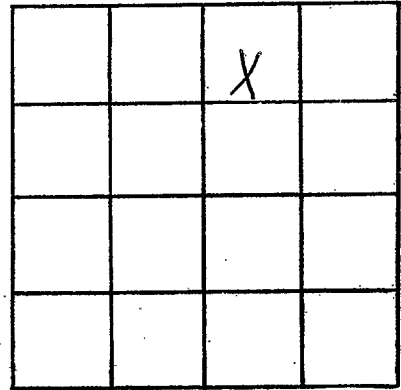

SECTION 17

Please indicate well location X.

ADDITIONAL INFORMATION

If more than one screen, show locations of each on sketch.