

*get better
Completion Data*

Washington
M62
11-75
Elev # 86

MISSISSIPPI
BOARD OF WATER COMMISSIONERS
416 North State Street
Jackson, Mississippi 39201
WATER WELL DRILLERS LOG

RECORDED

Nov-14-75 date well completed 19 T.M. PARKS firm name Washington county well located

LANDOWNER: City
City of Hollandale, MS.
Hollandale, MS.
(mailing address)

WELL LOCATION:
sec. 31 T. 16N R. 6 E
S W
1/2 miles N of Hollandale
(distance) (direction) (nearest town)

WELL PURPOSE: Municipal
(home, irrigation, municipal, industrial)

WELL COMPLETION DATA:

- (1) diameter (inches) 16"
- (2) total depth (feet) _____
- (3) static water level (feet) 30 below above top of ground.
- (4) casing 16" (material) (depth)
8" if telescope see back.
(size)
- (5) screen 86' 372'
(length) (depth to top)
8" Stainless
(size) (material)
- (6) pump 800
(HP) (yield gpm)
3 0
(type power)
- (7) electric log yes
(yes or no)
U.S.
(organization running log)
- (8) how well bottom plugged B.P.V.

description of formations encountered	from	to
Clays	0	21
Clay w/ sand	21	37
Sand w/ gravel	37	188
Clays, Chalk w/ Gumbo	188	290
Sand Fine	290	320
Tough Gumbo	320	345
Fine Sand (dirty)	345	368
SAND	368	432
Fine Sand w/ clays	432	460
Good Sand	460	495
Sandy CLAY	495	500


*307 top of cap
154'
372'-492'*

RECEIVED
NOV 10 1976
MISS. BD. OF WATER CONTROL

DRILLERS REMARKS: Yield
Very Good, Capacity
1000-1200 GPM @
20 gpf

If well telescopes please sketch and show depths.

GROUND LEVEL

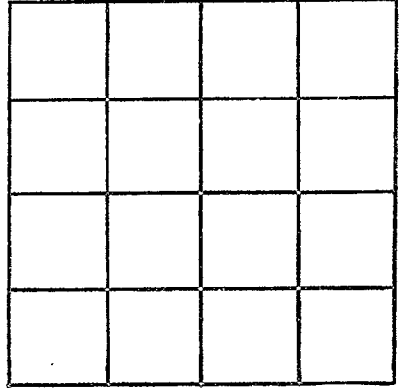

SECTION _____

Please indicate well location X.

ADDITIONAL INFORMATION

If more than one screen,
show locations of each on sketch.